


Section 29 Township 28 Range 32W
 Well No. #1 Walters
 Company Derby & Kuhn

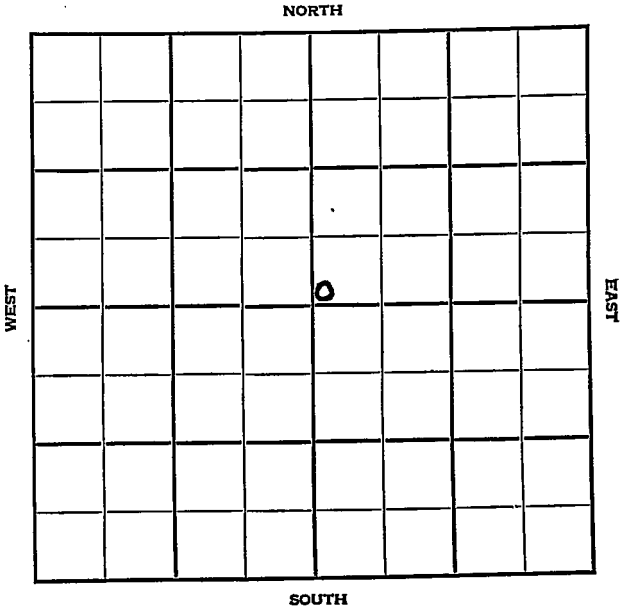

KANSAS

Haskell

Sec. 29 Twp. 28 R. 32W

Well No. #1 Walters Farm

Derby & Kuhn

Company

Hugoton Pool


Ft. from N. Line

100' Ft. from S. Line

Ft. from E. Line

100' Ft. from W. Line

SW NE

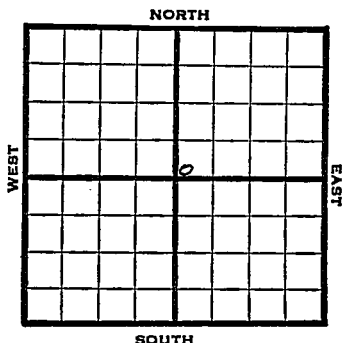

1948 Elev. 2931' REPORT

5/19	Drlg. 250'
5/26	10" @ 60g'
	TD 2625'
	7% @ 2615'
	RUST'
6/1	"
6/9	"
6/16	"
6/23	"
6/29	"
7/8	"
7/14	"
7/21	TD 2760'
	138' of 5" Perf Liner @ 2760'
7/28	"
8/4	"
8/11	TD 2760'
8/18	"
8/25	"
9/1	"
9/8	"
9/14	"

7-15

1948

9/22

7" @ 2615'

TD 2760'

138' of 5" Perf liner @ 2760

25,000 acid

Gas 8,957,000

R Pr. 370#

COMPLETED

Map No. _____ Sec. 29 Twp. 28 R. 32w

Well No. 1 Walters

Derby & Kuhn Company

-1ST REPORT Contractor

SW NE

SECTION PLAT

		o	

_____ Ft. from N. Line

100 Ft. from S. Line

_____ Ft. from E. Line

100 Ft. from W. Line

Haskell County

Location _____

Rig up _____

Drilling and Remarks:

drlg. 250

RECORD

Cased _____ in., _____ ft.

Sand _____

Gas _____

Oil _____

Total Depth _____

PRODUCTION

1st 24 hrs. Nat. _____

1st 24 hrs. after shot _____

Gas _____ Cu. Ft.

Dry Hole _____

Abandoned _____

Date

MAY 19 1948

19

S. J. LEWIS Scout


W. B. D. 100





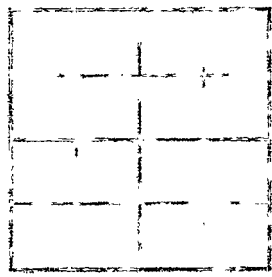




Misc. Small Maps	☒
Cards	☒
Tracing	☒
France Map	☒
Scarborough Map	☒
Pierce Map	☒
Geological Dept.	☐
Pierce Plat Books	☐



Haskell County Kansas State

Map No. _____ Sec. 29 Twp. 28 R. 32W

Well No. 1 Walters

Derby & Kuhn Company

COMPLETE

Contractor

E. 1.2931

SW NE

SECTION PLAT

_____ Ft. from N. Line

100 Ft. from S. Line

_____ Ft. from E. Line

100 Ft. from W. Line

Hugoton Pool

Remarks:

7" @ 2615

7152760

108' of 15" Perf. line @ 2760

20000 acrid

8,957,000 gal.

370 = R. P. H.

Date

SEP 22 1948

Scout

S. J. LEWIS

Misc. Small Maps

Cards

Tracing

France Map

Scarborough Map

Pierce Map

Geological Dept.

Pierce Plat Book