


Section 29 Township 28 Range 17-W

Well No. #1 Repp

Company Stanolind
Wildcat

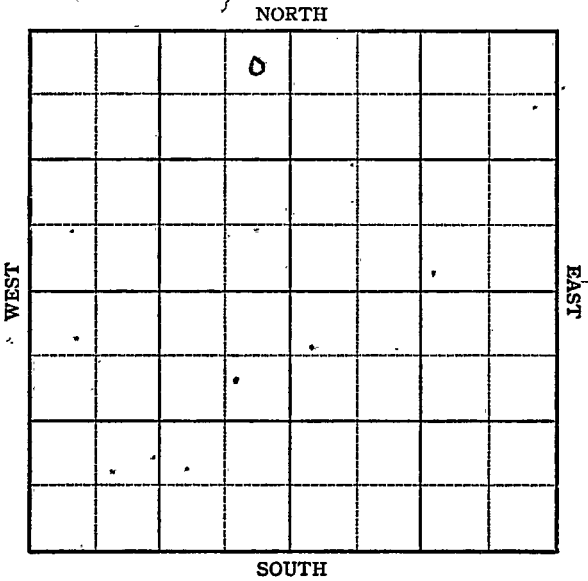


Sec. 29 Twp. 28 R. 17-WWell No. #1 Repp FarmStanolind Company

Wildcat

330 Ft. from N. Line Ft. from S. Line330 Ft. from E. Line Ft. from W. Line

NE NW

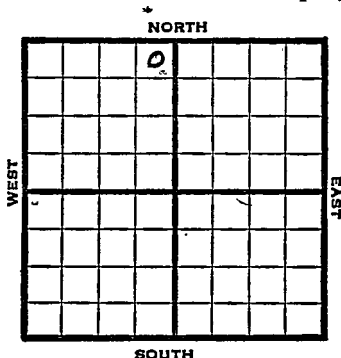

1947 Elev. 2236' REPORT

6/11 Location

6/17 "

6/24 "

7/1 15" @ 196'
WOC

7/8 Drlg. 2330'

7/16 Drlg 3602'

7/22 Lansing 4287
Drlg. 44897/29 Miss. 4851'
8" @ 1156'
TD 4861'8/6 Viola 4969'
Drlg 5017'8/13 Corrected Tops
Lansing 4277
Mississippi 4841
Viola 4959
Simpson 5088
Arbuckle 5147
TD 5159
Run csg.

OVER

1947

8/20 5" @ 5018'

8/27 "

9/3 Miss. 4841'
5" @ 5018'
Arb. 5147'
Perf. Miss.
500 acid
7,300,000 Gas
1250# R. Pr.
TD 5159'

COMPLETED

Map No. _____ Sec. 29 Twp. 28 R. 17W

Well No. 1 Repp _____

Stanolind _____ Company

FIRST REPORT

Contractor

NE NW


SECTION PLAT

330 Ft. from N. Line

_____ Ft. from S. Line

330 Ft. from E. Line

_____ Ft. from W. Line

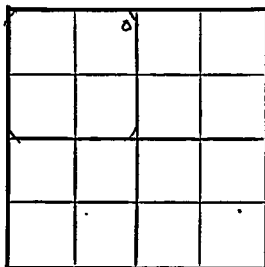

Kiowa County

Location X _____

Rig up _____

Drilling and Remarks: _____

RECORD

Cased _____ in., _____ ft.

Sand _____

Gas _____

Oil _____

Total Depth _____

PRODUCTION

1st 24 hrs. Nat. _____

1st 24 hrs. after shot _____

Gas _____ Cu. Ft.

Dry Hole _____

Abandoned _____

Date

JUN 11 1947 19

S. J. LEWIS Scout

Misc. Small Maps

Cards

Tracing

France Map

Scarborough Map

Pierce Map

Geological Dept.

Pierce Plat Book

Map No. 91 Sec. 29 Twp. 28 R. 17W

Well No. 1 Repp

Stanolind

Company


COMPLETE

Contractor

NE NW

E1,2236

SECTION PLAT

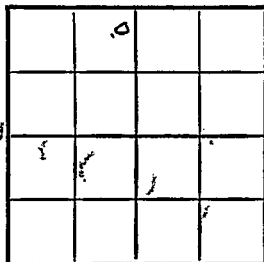

330 Ft. from N. Line

Ft. from S. Line

330 Ft. from E. Line

Ft. from W. Line

Kiowa County

Location

Rig up

Drilling and Remarks:

Miss 4541

5-105018

Re 45147

Perf Miss

500000

7,300,000 Gas

*1250 * R/P*

RECORD

Cased _____ in., _____ ft.

Sand _____

Gas _____

Oil _____

Total Depth 5159

PRODUCTION

1st 24 hrs. Nat. _____

1st 24 hrs. after shot _____

Gas _____ Cu. Ft.

Dry Hole _____

Abandoned _____

Date

SEP 3 1947 19

S. I. LEWIS

Scout

Wm

1 Misc Small Maps	
Cards	<i>Ruth</i>
Tracing	<i>P. C.</i>
France Map	<i>26</i>
Scarborough Map	<i>26</i>
Pierce Map	<i>26</i>
Geological Dept.	
Pierce Print Book	