


KANSAS

Pratt

Section 29 Township 28 Range 12W

Well No. #1 Fincham

Company Rine Drlg.
Wildcat

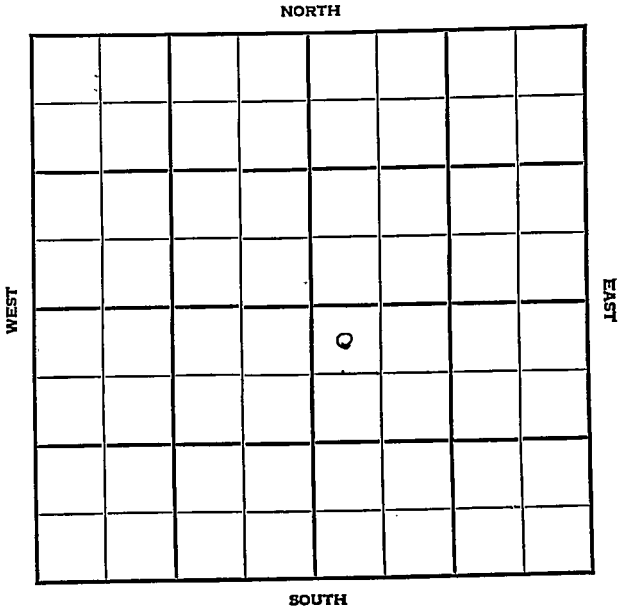

KANSAS

Pratt

✓

Sec. 29 Twp. 28 R. 12W

Well No. #1 Fincham Farm

Rine Drlg. Company

Wildcat


330' Ft. from N. Line

Ft. from S. Line

Ft. from E. Line

330' Ft. from W. Line

NW SE

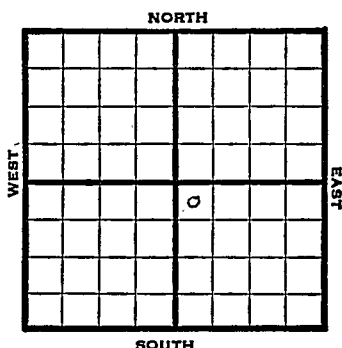

1948

Elev. 1911' REPORT

3/31

Location

4/7

"

4/14

"

4/21

RUR

4/28

8" @ 301'
Drlg. 2500'

5/5

Lost hole @ 3025'
Drlg. 2225'

5/12

Lansing 3794'
Drlg. 4010'

5/19

Mississippi 4241.
Viola 4400'
Simp. 4510'
Arbuckle 4625'
TD 4650'

ABANDONED

Map No. _____ Sec. 29 Twp. 28 R. 12W

Well No. 1 Fincham

Rine Drlg. _____ Company

FIRST REPORT _____ Contractor

NW SE


SECTION PLAT

330 Ft. from N. Line

_____ Ft. from S. Line

_____ Ft. from E. Line

330 Ft. from W. Line

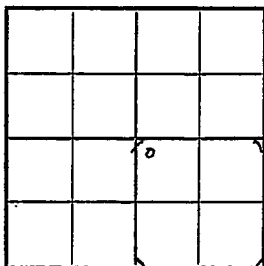

Pratt County

Location X

Rig up

Drilling and Remarks:

RECORD

Cased _____ in., _____ ft.

Sand _____

Gas _____

Oil _____

Total Depth _____

PRODUCTION

1st 24 hrs. Nat. _____

1st 24 hrs. after shot _____

Gas _____ Cu. Ft.

Dry Hole _____

Abandoned _____

Date

MAR 31 1948 19 S. J. LEWIS Scout

Map No. 54 Sec. 29 Twp. 28 R. 12W

Well No. 1 Fincham

Rine Drlg. Company

ARANDONET

Contractor

NW SE

E11911
SECTION PLAT

330 Ft. from N. Line

 Ft. from S. Line

 Ft. from E. Line

330 Ft. from W. Line

		0	

Pratt County

Location

Rig up

Drilling and Remarks:

Shut 4241
Shut 4400
Shut 4510
Shut 4625

RECORD

Cased in., ft.

Sand

Gas

Oil

Total Depth 4650

PRODUCTION

1st 24 hrs. Nat.

1st 24 hrs. after shot

Gas Cu. Ft.

Dry Hole

Abandoned

Date

MAY 19 1948 19 S. J. LEWIS Scout