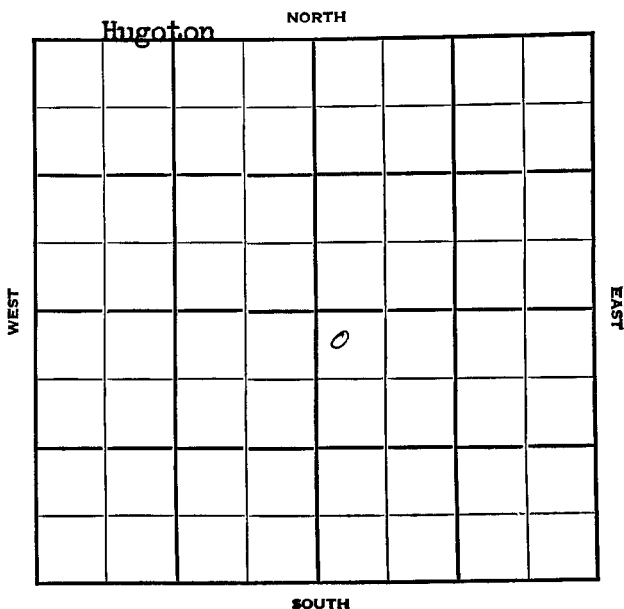


KANSAS

Stanton

Section 29 Township 28 Range 39WWell No. 1 Welch "C"Company Stanolind

Stanton

39-W ✓

Sec. 29 **KANSAS** Twp. 28 R. 38W

Well No. #1 Welch "C" Farm

Stanolind Company

Hugoton Pool


150' Ft. from N. Line

Ft. from S. Line

Ft. from E. Line

150' Ft. from W. Line

NW SE

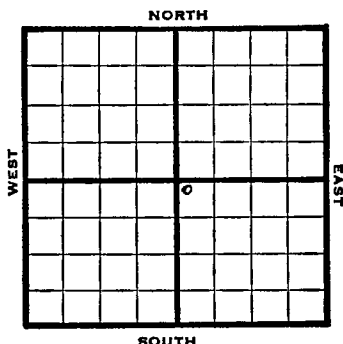

1948 Elev. 3191' REPORT

2/25	Location
3/3	10" @ 645' TD 2285' 7" @ 2267 ' RUST
3/10	TD 2485 fsg.
3/17	TD 2485' 13500 acid.
3/24	"
3/31	"
4/7	7" @ 2267' 230' of 5" Perf liner @ 2485' Acid 13,500 GAs 5,700,000 Rock Pr. 414# TD 2485'

COMPLETED

Map No. _____ Sec. 29 Twp. 28 R. 38W

Well No. 1 Welch "C"

Stanolind Company

FIRST REPORT

Contractor

NW SE

SECTION PLAT

		o	

150 Ft. from N. Line

_____ Ft. from S. Line

_____ Ft. from E. Line

150 Ft. from W. Line

Stanton County

Location X

Rig up _____

Drilling and Remarks:

RECORD

Cased _____ in., _____ ft.

Sand _____

Gas _____

Oil _____

Total Depth _____

PRODUCTION

1st 24 hrs. Nat. _____

1st 24 hrs. after shot _____

Gas _____ Cu. Ft.

Dry Hole _____

Abandoned _____

Date

FEB 25 1948

19

S. J. LEWIS Scout

~~Check County~~
~~Townships & Ranges.~~
~~T10 28S - 38N~~
~~St. Louis County.~~

Misc. Small Maps

Cards

Tracing

France Map

Scarborough Map

Pierce Map

Geological Dept.

Pierce Plat Book

Map No. NO 12P Sec. 29 Twp. 28 R. 39W

Well No. 1 Welch "C"

Stanolind Company

CORRECTION

Contractor

NE SE

SECTION PLAT

150 Ft. from N. Line

 Ft. from S. Line

 Ft. from E. Line

150 Ft. from W. Line

		o	

Stanton County

Location

Rig up

Drilling and Remarks:

Reported
29-28-38W

RECORD

Cased in., ft.

Sand

Gas

Oil

Total Depth

PRODUCTION

1st 24 hrs. Nat.

1st 24 hrs. after shot

Gas Cu. Ft.

Dry Hole

Abandoned

Date

MAR 3 1948 19 S. J. LEWIS Scout

Map No. _____ Sec. 29 Twp. 28 R. 39WWell No. 1 Welch "C"

Stanolind

Company

COMPLETE


Contractor

SE

E18791
SECTION PLAT150 Ft. from N. Line

_____ Ft. from S. Line

_____ Ft. from E. Line

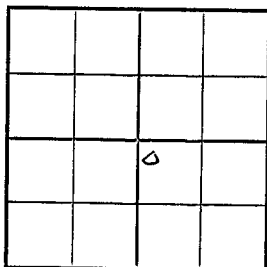150 Ft. from W. Line

Stanton County

Location _____

Rig up _____

Drilling and Remarks:

7" @ 2267

230' of 5" Perf. line

C2485.

13500 acid

5,700,000 gal

414 * R/3

RECORD

Cased _____ in., _____ ft.

Sand _____

Gas _____

Oil _____

Total Depth 2485

PRODUCTION

1st 24 hrs. Nat. _____

1st 24 hrs. after shot _____

Gas _____ Cu. Ft.

Dry Hole _____

Abandoned _____

Date

APR 7 1948 19

S. J. LEWIS Scout