

Pratt


KANSAS

DX 78-1

Section 29 Township 28S Range 11W

Well No. #1 Tipton

Company Cities Service & Sun Oil

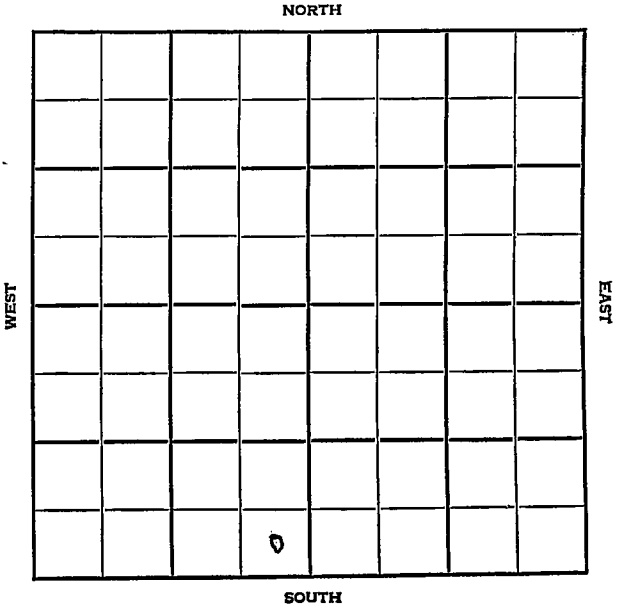

Pratt


SEC. 29 TWP. 28S R. 11W ^{KANSAS}

WELL NO. #1 Tipton FARM

COMPANY Cities Service & Sun Oil

CONTRACTOR Barbour Wildcat.

_____ Ft. from N. Line
 330 _____ Ft. from S. Line
 330 _____ Ft. from E. Line
 _____ Ft. from W. Line

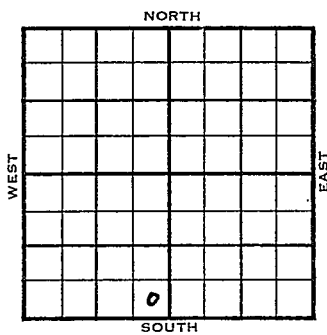

SE SE SW

	ELEVATION	REPORT
1954	1826'	

12/8	Location
1955 1/19	Spud 12-24-54 D & A TD 4619' 8" @ 365 Tor. 3109' Heeb 3545' Doug 3563' Br. lime 3691' Lans 3702' B KG 4103' Miss. 4166' EST 4167-80 open 1 hr rec 30' mud 95# Kh. 4243' Viola 4372 DST 4373-87 open 1 hr rec 32' mud. 40# Simp. sh. 4468 Simp. sd 4475 Arb. 4584 TD 4619' D & A

ABANDONED

