

Kingman


FORM 51 IOM 12-46 PETROL

KANSAS

Section 29 Township 28 Range 9W

Well No. 2 Darlington

Company Phillips

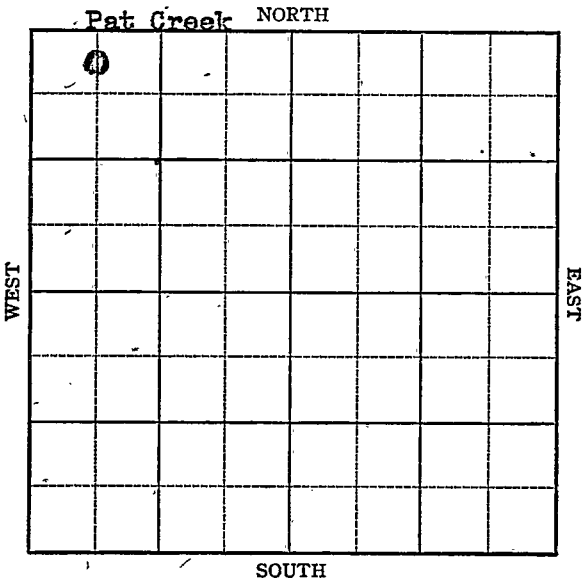

Sec. 29 Twp. 28 R. 9W

Well No. #2 Darlington Farm

Phillips Company

Pat Creek


330 Ft. from N. Line

Ft. from S. Line

Ft. from E. Line

660 Ft. from W. Line

C N L NW NW 1713 ?

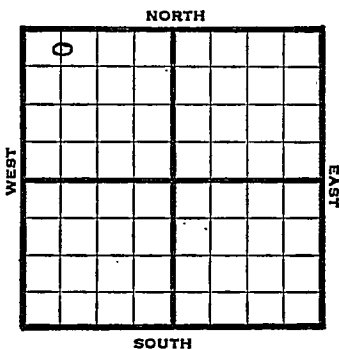

1947 Elev. 3713 REPORT

8/6	8" @ 460' WOC
8/13	Drlg. 3035'
8/20	Lansing 3565' Chat 4128' Drlg 4150'
8/27	Viola 4400' TD 4412' 5" @ 4400' RUST
9/3	TD 4402½'
9/10	TD 4403½' 11 shots 4400-02 500 acid Flow 6 bbls oil 1 hr.
9/17	TD 4402½'
9/24	"
10/1	Viola 4400 5" @ 4400 500 acid Bom & Pot 3000 TD 4403½' Gravity 40

COMPLETED

Map No. _____ Sec. 29 _____ Twp. 28 _____ R. 9W _____

Well No. 2 Darlington _____

Phillips _____ Company

FIRST REPORT

_____ Contractor

C N L NW NW


SECTION PLAT

330 _____ Ft. from N. Line

_____ Ft. from S. Line

_____ Ft. from E. Line

660 _____ Ft. from W. Line

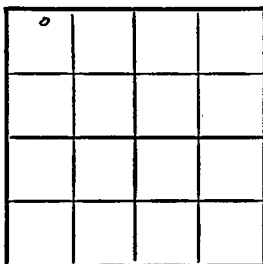

Kingman County

Location _____

Rig up _____

Drilling and Remarks:

8" @ 460' WOC

RECORD

Cased _____ in., _____ ft.

Sand _____

Gas _____

Oil _____

Total Depth _____

PRODUCTION

1st 24 hrs. Nat. _____

1st 24 hrs. after shot _____

Gas _____ Cu. Ft.

Dry Hole _____

Abandoned _____

Date

AUG 6 1947 19 _____ S. J. LEWIS Scout

Map No. 36 Sec. 29 Twp. 28 R. 9WWell No. 2 DarlingtonPhillips

Company

COMPLETE

Contractor

C N L NW NW

E1.3713

SECTION PLAT

330 Ft. from N. Line Ft. from S. Line Ft. from E. Line660 Ft. from W. Line

4			

Kingman CountyLocation Rig up

Drilling and Remarks:

1st 44005' @ 4400500 acidDone 1/2 1/2 200040-1-10

RECORD

Cased in., ft.Sand Gas Oil Total Depth 4408 1/2

PRODUCTION

1st 24 hrs. Nat. 1st 24 hrs. after shot Gas Cu. Ft.Dry Hole Abandoned

Date

OCT 1 1947

19

S. J. LEWIS

Scout