

Section 3 Township 28 Range 5WWell No. 1 YoungCompany Smitherman & Cohen

NORTH

WEST	0							
EAST								

SOUTH

Kingman

KANSAS

Sec. 3 Twp. 28 R. 5W

Well No. #1 Young Farm

Smitherman & Cohen Company

Contractor

Wildcat


330' Ft. from N. Line

Ft. from S. Line

Ft. from E. Line

330' Ft. from W. Line

NW NW NW

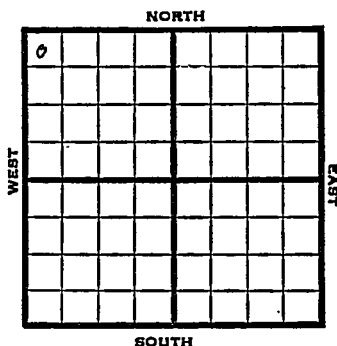


1951 Elev. 1441' REPORT

7/18 Spud 7-12-51
8" @ 156
Drlg. 2060'

8/8 Spud 7-12-51 D & A TD 3830'
8" @ 156 Br. lime 2927' Lans 2951'
Miss. chert 3764' Dol. 3813'
DST 3819-30 open 1 hr. rec 185' mud
& water TD 3830' D & A

ABANDONED

County Kingman State Kansas
 Sec. 3 (Blk.) 28 (Sur.) 5W Map No. _____
 Operator Smitherman & Cohen
 Well No. 1 Farm Young
 Elev. _____ Location NW NW NW

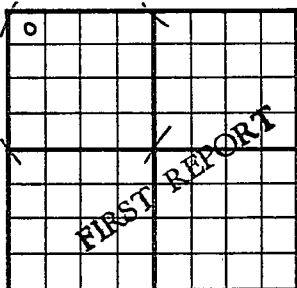


330 Ft. From N Line NW
330 Ft. From W Line Quarter
 1st. Report JUL 18 1951
 Completion _____
 Remarks _____
 Spudding Date 7-12-51

Drlg. Data Wildcat

8" @ 156 drlg. 2060

County Kingman State Kansas
 Sec. 3 (Blk. 28 (Sur. 5W Map No.
 (Twp.) (Rge.)
 Operator Smitherman & Cohen
 Well No. 1 Farm Young
 Elev. 1441 Location NW NW NW

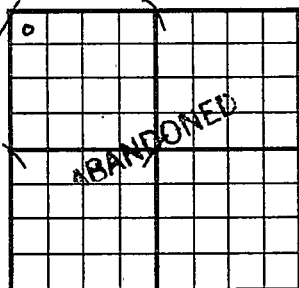

330 Ft. From N Line NW

330 Ft. From W Line Quarter

Ist. Report

Completion AUG 8 1951

Remarks Wildcat

Spudding Date 7-12-51

Drlg. Data D & A TD 3830

8" @ 156 Br. lime 2927 Lans. 2951

Miss. chert 3764 Dol. 3813

DST 3819-30 open' 1 hr. Rec. 185' mud

& water TD 3830

D & A