


Section 3 Township 28 Range 5-W

Well No. #1 Young

Company Leo Smitherman

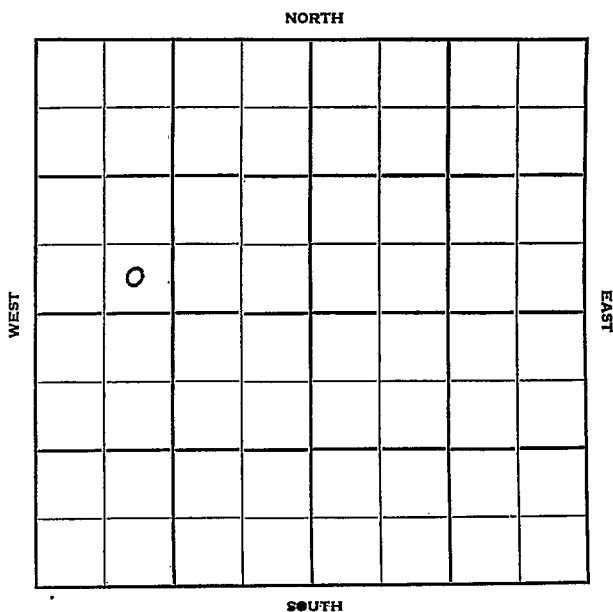

KANSAS

Kingman

3

28

5-W ✓

Sec. _____ Twp. _____ R. _____

Well No. #1 Young Farm _____

Leo Smitherman Company _____

Pabco Drlg. Contractor _____

Wildcat


_____ Ft. from N. Line

330 Ft. from S. Line

_____ Ft. from E. Line

990 Ft. from W. Line

SE SW NW

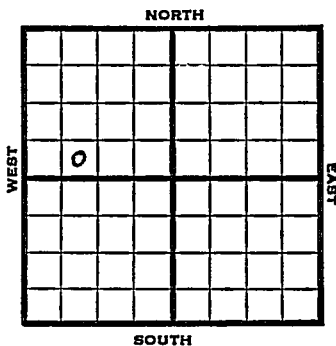

1951

Elev 1435'

REPORT

1/10

Spud 1-6-51

8" @ 158

Drlg 930'

1/24

8" @ 158

Br lime 2919

Lans 2954

Miss Chat 3757


Dol 3805

DST 3806-12 opn 1 hr rec 930' sw

DST 3812-3838 TD rec sw

D&A TD 3838'

ABANDONED

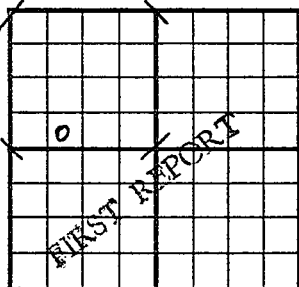
County Kingman State KansasSec. 3 (Blk.) 28 (Sur.) 5W Map No.Operator Leo SmithermanWell No. 1 Farm YoungElev. Location SE SW NW330 Ft. From S Line NW990 Ft. From W Line Quarter1st. Report JAN 10 1951

Completion

Remarks

Pabco Drlg. - Contr.Spudding Date 1-6-51Drlg. Data Wildcat8" @ 158 drlg. 930

County Kingman State Kansas
 Sec. 3 (Blk.) 28 (Sur.) 5W Map No.
 Operator Leo Smitherman
 Well No. 1 Farm Young
 Elev. 1435 Location SE SW NW

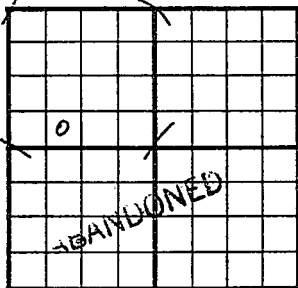

330 Ft. From S Line NW
990 Ft. From W Line Quarter

1st. Report

Completion JAN 24 1951

Remarks Wildcat

Pabco Drlg. - Contr.

Spudding Date 1-6-51

Drlg. Data D & A TD 3838

8" @ 158 Br. lime 2919 Lans. 2954

Miss. chat 3757 Dol. 3805 DST 3806-12

open 1 hr. Rec. 930' sw DST 3812-3838 TD

Rec. sw D & A

J. E. TYRA