


KANSAS

Grant county

Section 3 Township 28 Range 38-W

Well No. #1, H. L. Gudney

Company Stanolind O&G

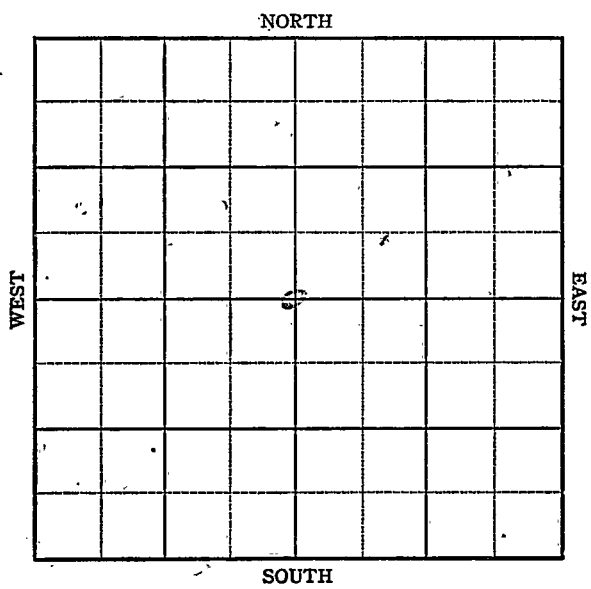

KANSAS

Grant County

Sec. 3 Twp. 28 R. 38W

Well No. 1 H. L. Cudney Farm

Stanolind Company


Hugoton Pool

2640 Ft. from N. Line

 Ft. from S. Line

2640 Ft. from E. Line

 Ft. from W. Line

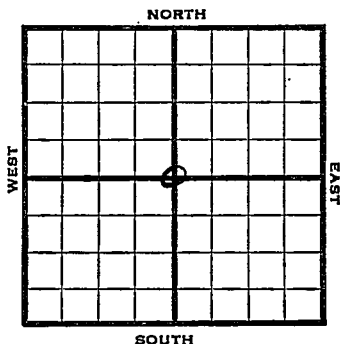

C Sec.

1947	Elev. 3091 REPORT
1/2	8" @ 604'
	WOC
1/8	Dr1g 2532'
1/15	TD 2562'
	5" @ 2522
	RUST
1/21	72 shots 2314-26
	222 shots 2345-82
	192 " 2400-32
	2280 " 2470-98
	16000 Acid
2/12	5" @ 2522
	Perf
	16,000 Acid
	1,665,000 Gas
	TD 2562'

COMPLETED

Map No. _____ Sec. 3 Twp. 28 R. 38WWell No. 1 H. L. Cudney

Stanolind _____ Company

FIRST REPORT _____ Contractor

C Sec. _____


SECTION PLAT2640 Ft. from N. Line

_____ Ft. from S. Line

2640 Ft. from E. Line

_____ Ft. from W. Line

Grant County

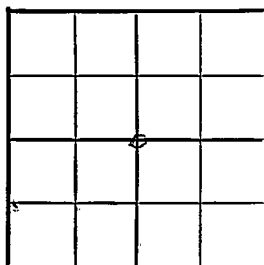

Location _____

Rig up _____

Drilling and Remarks:

8" @ 604 WOC**RECORD**

Cased _____ in. _____ ft.

Sand _____

Gas _____

Oil _____

Total Depth _____

PRODUCTION

1st 24 hrs. Nat. _____

1st 24 hrs. after shot _____

Gas _____ Cu. Ft.

Dry Hole _____

Abandoned _____

Date

JAN 2 1947 19S. J. LEWIS Scout

Kansas **KANSAS**

Hugoton Pool

Map No. _____ Sec. 3 Twp. 28 R. 38WWell No. 1 H. L. Cudney

_____ Stanolind _____ Company

_____ COMPLETE _____ Contractor

C Sec. _____

E 13091


SECTION PLAT

2640 Ft. from N. Line

_____ Ft. from S. Line

2640 Ft. from E. Line

_____ Ft. from W. Line

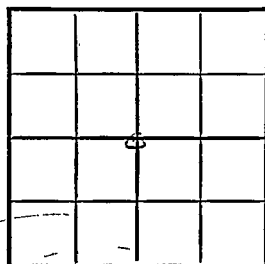

Grant County

Location _____

Rig up _____

Drilling and Remarks:

5' to 2522

Perf.
1600 acid
1,665,000 Gas

RECORD

Cased _____ in., _____ ft.

Sand _____

Gas _____

Oil _____

Total Depth 2562

PRODUCTION

1st 24 hrs. Nat. _____

1st 24 hrs. after shot _____

Gas _____ Cu. Ft.

Dry Hole _____

Abandoned _____

Date

FEB 12 1947 19S. J. LEWIS Scout