


Section 3 Township 28 Range 39-WWell No. 1 MoncurCompany Stanolind

Hugoton Pool

NORTH

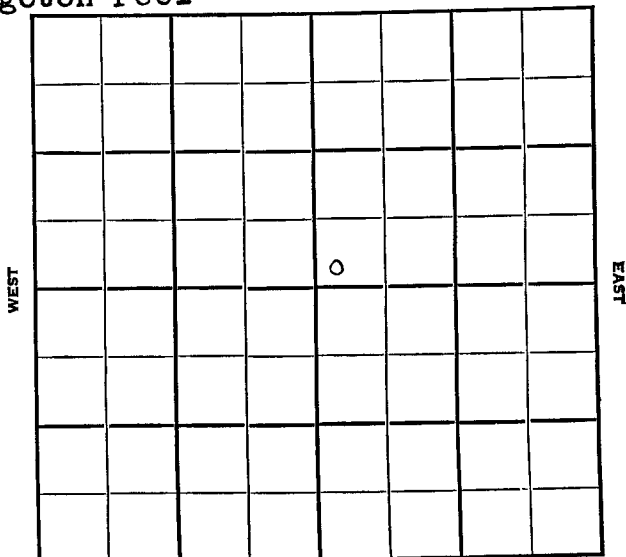

SOUTH

KANSAS

Stanton



Sec. 3 Twp. 28 R. 39W

Well No. #1 Moncur Farm

Stanolind Company


Hugoton

Ft. from N. Line

150 Ft. from S. Line

Ft. from E. Line

150 Ft. from W. Line

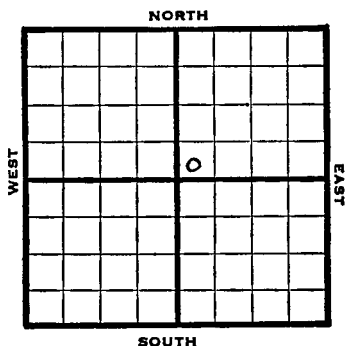

SW NE

1947 Elev. 3160' REPORT

10/1 Drlg. 696'

10/8 10" @ 346'
Drlg. 2426'

10/15 "

10/22 7" @ 2291'
226' of 5" Perf Liner @ 2490'
17,000 Acid
7,200,000 Gas
Rock Pressure 410#
Total Depth 2490'
COMPLETED

Map No. _____ Sec. 3 Twp. 28 R. 39W

Well No. 1 Honour

Stanolind

Company

FIRST REPORT

Contractor

SW NE

SECTION PLAT

_____ Ft. from N. Line

150 Ft. from S. Line

_____ Ft. from E. Line

150 Ft. from W. Line

Stanton County

Location _____

Rig up _____

Drilling and Remarks:

drlg. 696

RECORD

Cased _____ in., _____ ft.

Sand _____

Gas _____

Oil _____

Total Depth _____

PRODUCTION

1st 24 hrs. Nat. _____

1st 24 hrs. after shot _____

Gas _____ Cu. Ft.

Dry Hole _____

Abandoned _____

Date

OCT 1 1947 19

S. J. LEWIS Scout

Map No. 0 Sec. 3 Twp. 28 R. 39W

Well No. 1 Moncur

Stanolind

Company

COMPLETE

Contractor

SW NE

E18160

SECTION PLAT

		0	

Ft. from N. Line

150

Ft. from S. Line

Ft. from E. Line

150

Ft. from W. Line

Stanton County

Location

Rig up

Drilling and Remarks:

7" @ 2291

226' of 5" Pay line

@ 2490

17000 @ acid

7,200,000 - Gas

#10 # R/P

RECORD

Cased _____ in., _____ ft.

Sand _____

Gas _____

Oil _____

Total Depth 2490

PRODUCTION

1st 24 hrs. Nat. _____

1st 24 hrs. after shot _____

Gas _____ Cu. Ft.

Dry Hole _____

Abandoned _____

Date

OCT 22 1947 19

S. J. LEWIS

Scout