


KANSAS Pratt

FORM 51 25M 3-49 PETROL

Section 3 Township 28 Range 12-W

Well No. #1 M Rosenbaum

Company Rine Drlg  
Wildcat

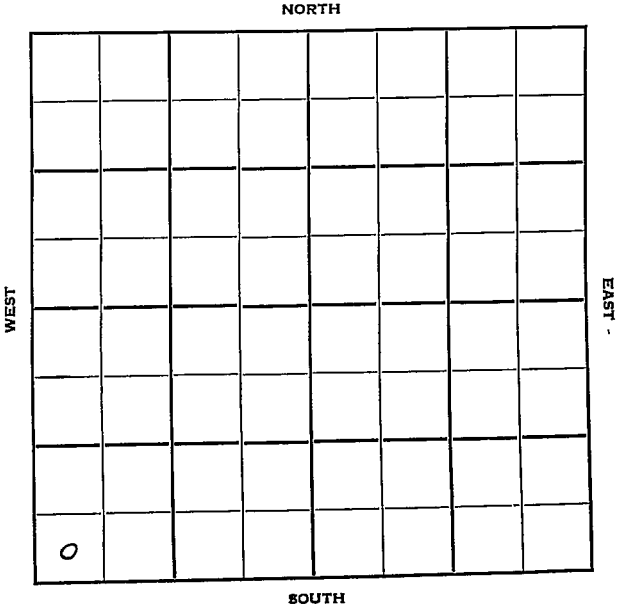

Pratt KANSAS

Sec. 3 Twp. 28 R. 12W ✓

Well No. #1 M.-Rosenbaum Farm

Rine Drlg. Company

Rine Drlg. Contractor

Wildcat

Ft. from N. Line

330'


Ft. from S. Line

Ft. from E. Line

330'

Ft. from W. Line

SW SW SW

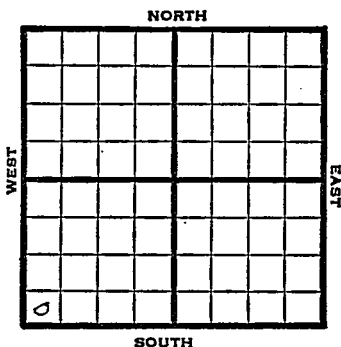

1950

REPORT

3/8

Spud 3-5-50  
8-5/8" @ 298'  
Drlg. 2220'

4/5

TD 4610'  
8 5/8" @ 298'  
Lans 3720'  
Viola 4361'  
Simp 4454'  
Miss 4172  
Arb 4558'  
5"@ 3958'  
D&A<sub>IN</sub>  
Aband  
r

**ABANDONED**

Kansas

Map No. \_\_\_\_\_ Sec. 3 Twp. 28 R. 12WWell No. 1 M. Rosenbaum

\_\_\_\_\_ Rine Drlg. \_\_\_\_\_ Company

\_\_\_\_\_ Rine Drlg. \_\_\_\_\_ Contractor


SW SW SW

## SECTION PLAT

\_\_\_\_\_ Ft. from N. Line

330 Ft. from S. Line

\_\_\_\_\_ Ft. from E. Line

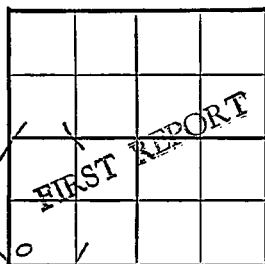330 Ft. from W. LinePratt County Sun & Lion DHM

Location \_\_\_\_\_

Rig up \_\_\_\_\_

Drilling and Remarks:

Spud 3-5-50

8 5/8" @ 298

drlg. 2220

## RECORD

Cased \_\_\_\_\_ in., \_\_\_\_\_ ft.

Sand \_\_\_\_\_

Gas \_\_\_\_\_

Oil \_\_\_\_\_

Total Depth \_\_\_\_\_

## PRODUCTION

1st 24 hrs. Nat. \_\_\_\_\_

1st 24 hrs. after shot \_\_\_\_\_

Gas \_\_\_\_\_ Cu. Ft.

Dry Hole \_\_\_\_\_

Abandoned \_\_\_\_\_


Date

MAR 8 1950

19

J. E. TYRA

Scout

 

1. Map of the

2. 12 " " "

3. 12 " " "

4. 12 " " "

Scout Cards

Land Small Map

Land Wall Map

Tracings

France Map

Pierce Map

Misc.


MAR 10 1950

Map No. \_\_\_\_\_ Sec. 3 Twp. 28 R. 12WWell No. 1 M. Rosenbaum

\_\_\_\_\_ Rine Drlg. \_\_\_\_\_ Company

\_\_\_\_\_ Contractor  
SW SW SW

## SECTION PLAT

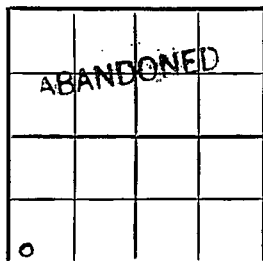

\_\_\_\_\_ Ft. from N. Line

330 Ft. from S. Line

\_\_\_\_\_ Ft. from E. Line

330 Ft. from W. Line

Pratt County

Location \_\_\_\_\_

Rig up \_\_\_\_\_

Drilling and Remarks:

*8 5/8" @ 298*  
*Land 3720*  
*Viola 4361*  
*Simp 4454*  
*Miss 4172*  
*arb 4558*

## RECORD

Cased \_\_\_\_\_ in., \_\_\_\_\_ ft.

Sand \_\_\_\_\_

Gas \_\_\_\_\_

Oil \_\_\_\_\_

Total Depth 4610

## PRODUCTION

1st 24 hrs. Nat. \_\_\_\_\_

1st 24 hrs. after shot \_\_\_\_\_

Gas \_\_\_\_\_ Cu. Ft.

Dry Hole \_\_\_\_\_

Abandoned \_\_\_\_\_

Date

APR 5

