

Sec. 3 Twp. 28 R. 11-W

Well No. #1 Bowers Farm


Skelly etal Company

660 Ft. from N. Line

_____ Ft. from S. Line

330 Ft. from E. Line

_____ Ft. from W. Line

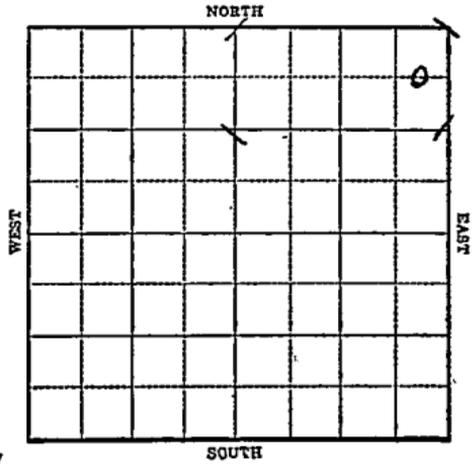

ELEV. 1736

1943

R E P O R T

9/8 Derrick
 9/15 8" @ 384
 WOG.
 9/22 Drlg. 2405'
 9/29 Lans 3496
 T.D. 3507
 5" @ 3500
 Rust
 10/6 "
 10/13 "
 10/20 T.D. 3549
 10/27 Lans 3496
 5" @ 3500
 5000. acid
 Pump 163 Pot.
 T.D. 3549'
 Gravity 36.3

COMPLETED

KANSAS

Map No. 54 Sec. 3 Twp. 28 R. 11WWell No. 1 BowersSkelly etal Company

FIRST REPORT Contractor

C E L N E N E
660 Ft. from N. Line


_____ Ft. from S. Line

330 Ft. from E. Line

_____ Ft. from W. Line

Cunningham Pool

SECTION PLAT

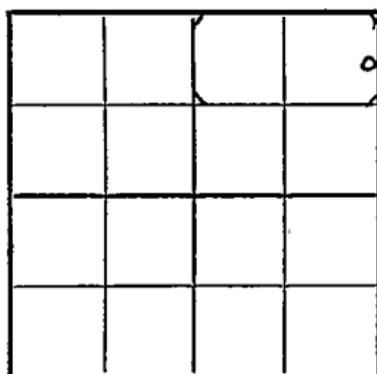

Location _____

Rig up _____

Drilling and Remarks:

Derrick

RECORD

Cased _____ in., _____ ft.

Sand _____

Gas _____

Oil _____

Total Depth _____

PRODUCTION

1st 24 hrs. Nat. _____

1st 24 hrs. after shot _____

Gas _____ Cu. Ft.

Dry Hole _____

Abandoned _____

Date

SEP 8 1943 19

S. J. LEWIS Scout

KANSAS

Map No. 57 Sec. 3 Twp. 28 R. 11W

Well No. 7 Bowers

Skelly et al. Company

COMPLETED Contractor

C E L N E N E

SECTION PLAT

660 Ft. from N. Line

_____ Ft. from S. Line

330 Ft. from E. Line

_____ Ft. from W. Line

			6

Cunningham Pool

Location _____

Rig up _____

Drilling and Remarks:

Lease 3496

5103500

5000 acid

Pump 1630

26 3/4

RECORD

Cased _____ in., _____ ft.

Sand _____

Gas _____

Oil _____

Total Depth 2547

PRODUCTION

1st 24 hrs. Nat. _____

1st 24 hrs. after shot _____

Gas _____ Cu. Ft.

Dry Hole _____

Abandoned _____

Date

Oct 27 1943 19

S. J. LEWIS Scout