


Pratt

Section 3 Township 28 Range 11W

Well No. #4 Royse

Company Tidewater

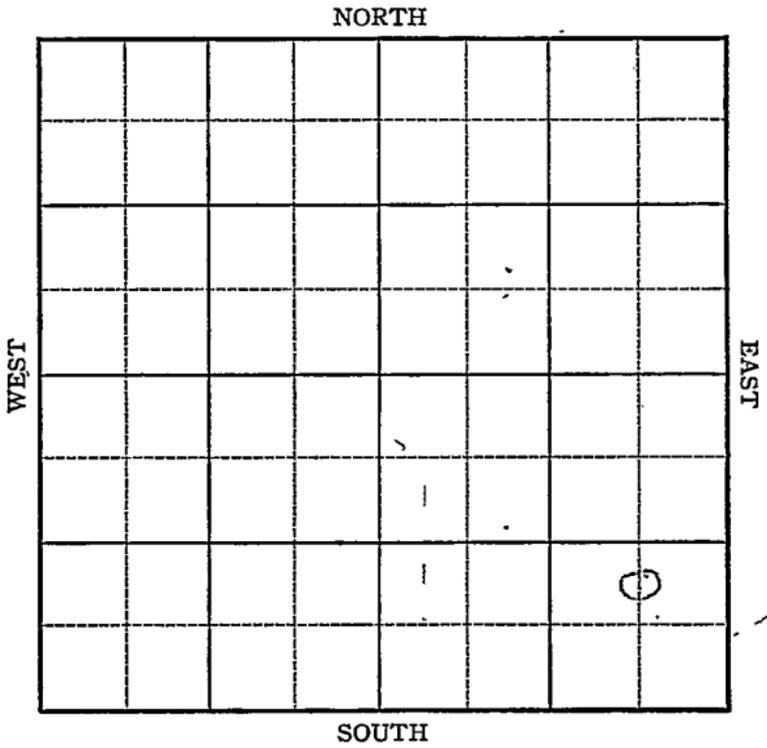

Sec. 3 Twp. 28 R. 11W

Well No. #4 Royse Farm

Tidewater Company

Cunningham


NORTH

           Ft. from N. Line

990 Ft. from S. Line

660 Ft. from E. Line

           Ft. from W. Line

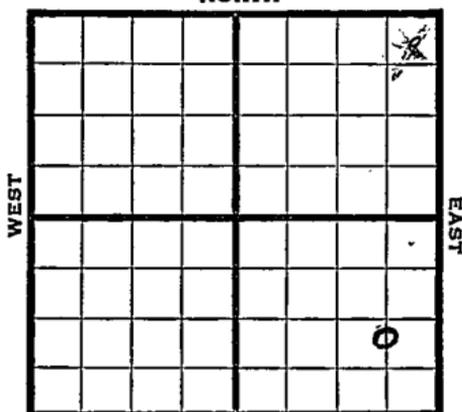

8120.1761

C 112 SE SE

1944

### REPORT

7/19 Locl  
 7/26 8" @ 448 Drlg. 515  
 8/2 Drlg. 3490  
 Lans 3530  
 5" @ 3531 TD 3552 RUST  
 8/16 TD 3579 500 acid swb 4 oil per hr.  
 8/23 " " " " " " " "  
 8/30 Lans 3530  
 5" @ 3531  
 500 acid  
 pump 120 pot.  
 TD 3579  
 Grav. 41.

COMPLETED

Pool Name CunninghamMap No. KANSAS Sec. 3 Twp. 28 R. 11WWell No. 4 RoyseTidewater CompanyFIRST REPORT ContractorC NL SE SE

## SECTION PLAT

			o

         Ft. from N. Line990 Ft. from S. Line660 Ft. from E. Line         Ft. from W. LinePratt CountyLocation XRig up         

Drilling and Remarks:

## RECORD

Cased          in.,          ft.Sand         Gas         Oil         Total Depth         

## PRODUCTION

1st 24 hrs. Nat.         1st 24 hrs. after shot         Gas          Cu. Ft.Dry Hole         Abandoned         

Date

JUL 1 9 1944 19S. J. LEWIS Scout

