

KANSAS


Pratt  
Cotton

FORM 51 5M 1-42 PETROL

Section 3 Township 28 Range 11 W

Well No. #3 Royse

Company Tidewater

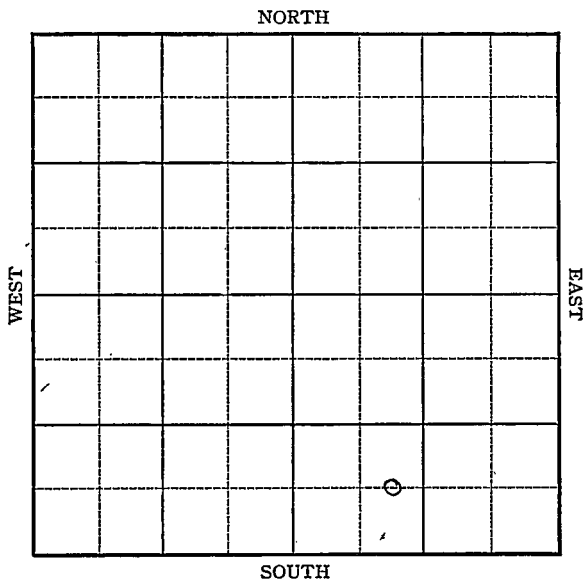

KANSAS

Pratt

Sec. 3 Twp. 28 R. 11W

Well No. #3 Royse Farm  
Tidewater Company

Cunningham


NORTH

         Ft. from N. Line

660 Ft. from S. Line

         Ft. from E. Line

990 Ft. from W. Line

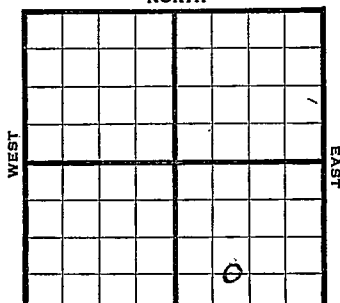

*Elev. 1755*

REPORT

1944

5/10 Loc  
5/17 8" - 436 WOC

5/24 Drlg. 2580

5/31 Lans 3523-38 TD  
5" @ 3536 RUST

6/7 "

6/15 Drlg. 3549

6/21 TD 3570  
500 acid flow 10 oil per hr.

7/5 5" @ 3536  
Lans. 3523  
TD 3570  
500 acid  
Pump 675 Pot.  
41.0 Gravity

**COMPLETED**

Pool Name CunninghamKANSAS 8 1Map No. 8 Sec. 3 Twp. 28 R. 11WWell No. 3 hoysTidewater

Company

## FIRST REPORT

Contractor

C E L SW SE

## SECTION PLAT

|  |  |  |  |
|--|--|--|--|
|  |  |  |  |
|  |  |  |  |
|  |  |  |  |
|  |  |  |  |
|  |  |  |  |

         Ft. from N. Line660         Ft. from S. Line         Ft. from E. Line990         Ft. from W. Line

Pratt County

Location XRig up         

Drilling and Remarks:

## RECORD

Cased          in.,          ft.Sand         Gas         Oil         Total Depth         

## PRODUCTION

1st 24 hrs. Nat.         1st 24 hrs. after shot         Gas          Cu. Ft.Dry Hole         Abandoned         

Date

MAY 10 1944

19

S. J. LEWIS


Scout

KANSAS

Pool Name CunninghamMap No. 54 Sec. 3 Twp. 28 R. 11WWell No. 3 RoyseTidewater CompanyCOMPLETED Contractor

C E L SW SE

## SECTION PLAT

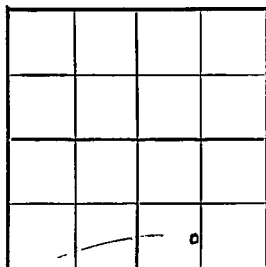         Ft. from N. Line660 Ft. from S. Line         Ft. from E. Line990 Ft. from W. LinePratt CountyLocation                                 Rig up                                 

Drilling and Remarks:

Lease 35235" @ 3536500 acidProd 75 Bbl.41° E

## RECORD

Cased          in.,          ft.Sand                                 Gas                                 Oil                                 Total Depth 3570

## PRODUCTION

1st 24 hrs. Nat.                                 1st 24 hrs. after shot                                 Gas                                  Cu. Ft.Dry Hole                                 Abandoned                                 

Date

JUL 5 1944 19 S. J. LEWIS Scout