


Section 3 Township 28 Range 11W

Well No. #1 F.H. Sellon


Company Gulf

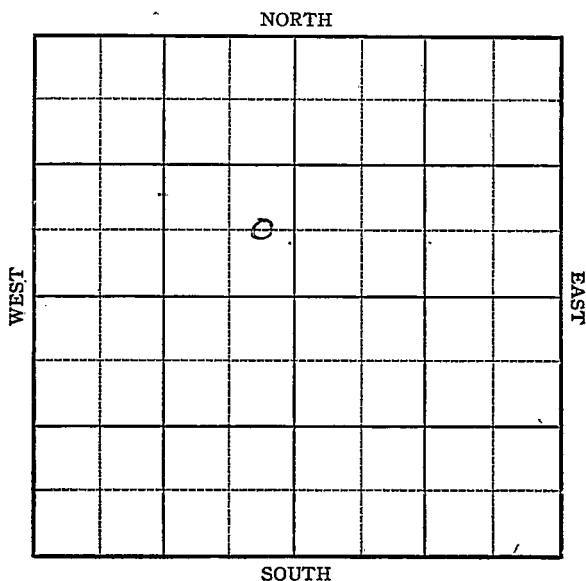

Sec. 3 Twp. 28 R. 11-W

Well No. #1 F. H. Sellon Farm

Gulf Company

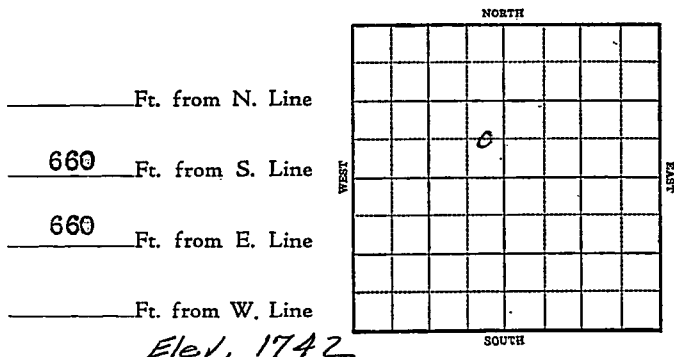

1944

R E P O R T

1/26 Rotary

2/2 8" @ 395

2/8 Drlg. 2117
Lans 3504-11 TD
5" @ 3510
Rust

2/15 TD 3555 1 gal oil per hr.

2/23 2000 acid

Pump 34 oil in 24 hrs.

3/1 5" @ 3510
Lasn 3504
TD 3555'
8000 acid
Pump 150 oil & 10% water Pot.
Gravity 36

COMPLETED

KANSAS


Map No. 24 Sec. 3 Twp. 28 R. 11WWell No. 1 F. H. SellonGulf Company

FIRST REPORT

Contractor

C E L S E N W

SECTION PLAT

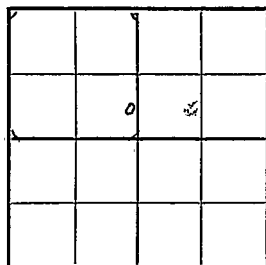 Ft. from N. Line660 Ft. from S. Line330 Ft. from E. Line Ft. from W. Line

Cunningham Pool

Location Rig up

Drilling and Remarks:

Rotary

RECORD

Cased in., ft.Sand Gas Oil Total Depth

PRODUCTION

1st 24 hrs. Nat. 1st 24 hrs. after shot Gas Cu. Ft.Dry Hole Abandoned

Date

JAN 26 1944 19 S. J. LEWIS Scout

Map No. KANSAS Sec. 3 Twp. 28 R. 11W
 Well No. 1 F. H. Sellon

Gulf


Company

COMPLETED

Contractor

C E L S E N W

SECTION PLAT

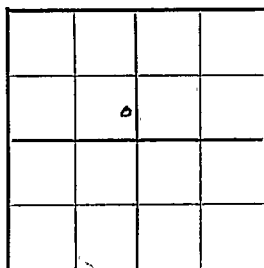

_____ Ft. from N. Line

660 Ft. from S. Line330 Ft. from E. Line

_____ Ft. from W. Line

Cunningham Pool

Location _____

Rig up _____

Drilling and Remarks:

*Loss 350.4**5' to 3510**8000 acft**Pump 150 oil + 10%**Water 20 ft**36° E*

RECORD

Cased _____ in., _____ ft.

Sand _____

Gas _____

Oil _____

Total Depth 3555

PRODUCTION

1st 24 hrs. Nat. _____

1st 24 hrs. after shot _____

Gas _____ Cu. Ft.

Dry Hole _____

Abandoned _____

Date

MAR 1 1944 19

S. J. LEWIS

Scout