

KANSAS


FORM 51 IOM 12-46 PETROL

Grant county

Section 30 Township 28 Range 37-W

Well No. #1, C. W. Hikok

Company Stanolind Oil and Gas Company

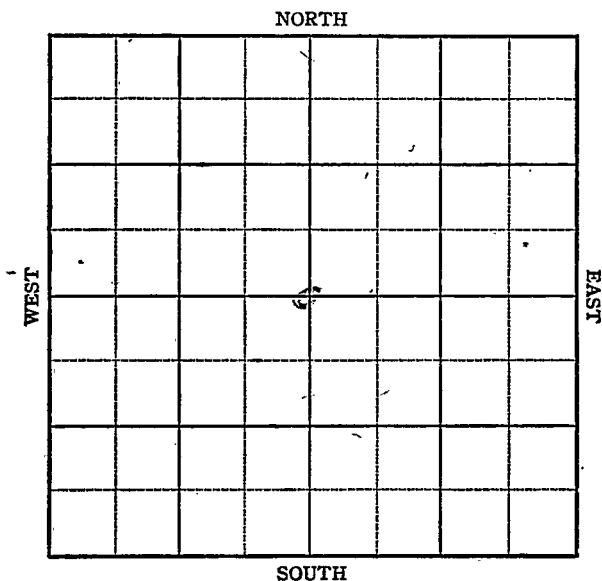

Grant county

Sec. 30 **KANSAS** Twp. 28 R. 37-W

Well No. #1, C. W. Hickok Farm

Stanolind Oil and Gas Co. Company

Hugoton Pool

2640'


Ft. from N. Line

Ft. from S. Line

2640'

Ft. from E. Line

Ft. from W. Line

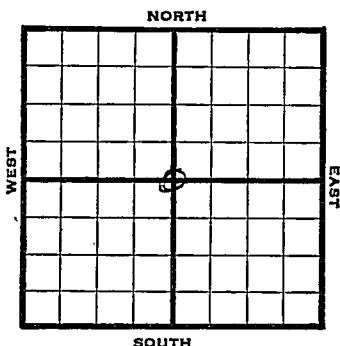

C Section

1946 Elev. 3088 **REPORT**

12/18 Drlg. 620'
Run Cag.

1947

1/4 TD 2625'
5" @ 2590'
66 shot 2380-91
306 shots 2404-55
162 shots 2477-2504
180 shots 2538-68, 2500 acid

1/15 5" @ 2590'
TD 2615
PPerf
17000 Acid
8,175,000 Gas
420# R PR

COMPLETED

~~Kansas~~ **KANSAS**~~Augoton Pool~~Map No. _____ Sec. 30 Twp. 28 R. 37WWell No. 1 C. W. Hickok

Stanolind

Company

FIRST REPORT

Contractor


C Sec.

SECTION PLAT2640 Ft. from N. Line

_____ Ft. from S. Line

2640 Ft. from E. Line

_____ Ft. from W. Line

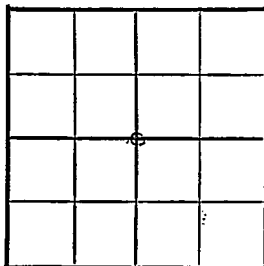Grant County

Location _____

Rig up _____

Drilling and Remarks:

620 run ssg.

RECORD

Cased _____ in., _____ ft.

Sand _____

Gas _____

Oil _____

Total Depth _____

PRODUCTION

1st 24 hrs. Nat. _____

1st 24 hrs. after shot _____

Gas _____ Cu. Ft.

Dry Hole _____

Abandoned _____

Date

DEC 1 8 1946 19S. J. LEWIS

Scout

KANSAS
Kansas

Hugoton Pool

Map No. _____ Sec. 30 Twp. 28 R. 37WWell No. 1 C. W. Hickok

Stanolind _____ Company

COMPLETE

Contractor


C Sec.

EJ. 3088
SECTION PLAT2640 Ft. from N. Line

_____ Ft. from S. Line

2640 Ft. from E. Line

_____ Ft. from W. Line

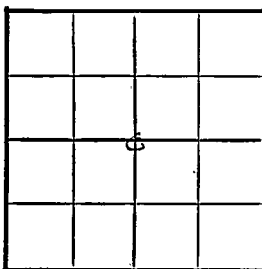

Grant County

Location _____

Rig up _____

Drilling and Remarks:

5" C2090
Perf.
17000 rods
5,175,000 lbs

RECORD

Cased _____ in., _____ ft.

Sand _____

Gas _____

Oil _____

Total Depth 2645

PRODUCTION

1st 24 hrs. Nat. _____

1st 24 hrs. after shot _____

Gas _____ Cu. Ft.

Dry Hole _____

Abandoned _____

Date

JAN 15 1947 19

S. J. LEWIS Scout