

KANSAS


Haskell

FORM 51 5M PETROL

Section 30 Township 28 Range 33W

Well No. 1 Laird "B"

Company Cities Service etal

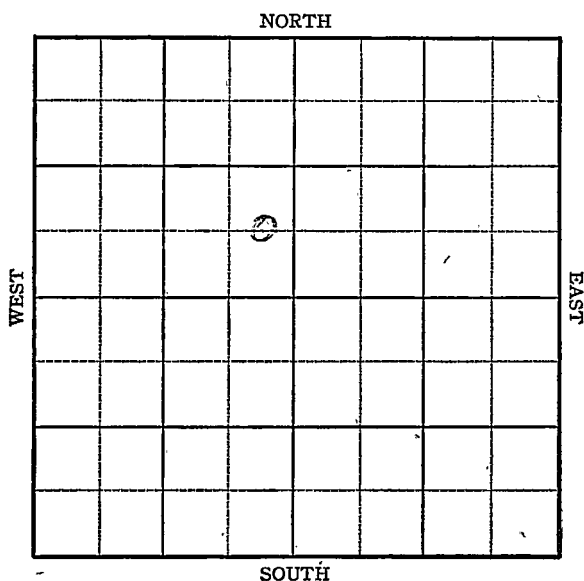

KANSAS Haskell

Sec. 30 Twp. 28 R. 33-W

Well No. #1 Laird "B" Farm


Cities Service etal Company

Ft. from N. Line

660 Ft. from S. Line

100 Ft. from E. Line

Ft. from W. Line

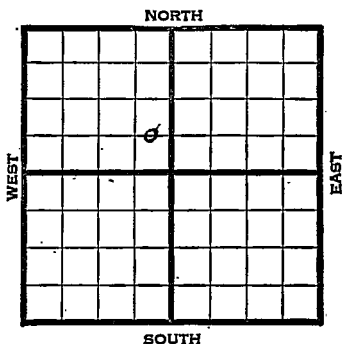

C E L S E N W

1945

Elev. 2973

R E P O R T

8/8 Drlg. 640

8/15 8" @ 747

Drlg. 2586

8/22 5" @ 2808

TD 2809 RUST

8/29 " " "

9/5 " " "

9/12 " " "

9/19 " " "

9/26 62 shots 2626-2764

91,000 Gas SW

10/3 13500 acid.

10/10 1500 acid.

10/17 " "

10/24 5" @ 2808

Perf. 28,500 acid.

TD 2809'

12,460,000 Gas.

410# R Pr.

COMPLETED

KANSAS

Pool Name HugotonMap No. 30 Sec. 30 Twp. 28 R. 33WWell No. 1 Laird "B"

Cities Service etal

Company

FIRST REPORT

Contractor

C E L SE NW

SECTION PLAT

Ft. from N. Line

660

Ft. from S. Line

100

Ft. from E. Line

Ft. from W. Line

Haskell County

Location

Rig up

Drilling and Remarks:

640'

RECORD

Cased in. ft.

Sand

Gas

Oil

Total Depth

PRODUCTION

1st 24 hrs. Nat.

1st 24 hrs. after shot

Gas

Cu. Ft.

Dry Hole

Abandoned

Date

AUG 8 1945 19

S. J. LEWIS

Scout

Kansas Pool Name Hugoton

KANSAS

Map No. map Sec. 30 Twp. 28 R. 33WWell No. 1 Laird "B"


Cities Service etal

Company

COMPLETED

Contractor

C E L SE NW

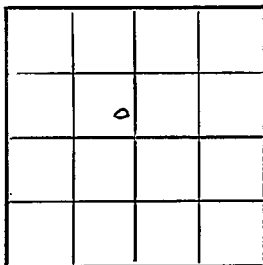E 12973
SECTION PLAT

Ft. from N. Line

660 Ft. from S. Line

100 Ft. from E. Line

Ft. from W. Line

Haskell County

Location

Rig up

Drilling and Remarks:

5" Cased

Perf.

28000 acid

12,460,000 Gas

4/10 R/P

RECORD

Cased in, ft.

Sand

Gas

Oil

Total Depth 2809

PRODUCTION

1st 24 hrs. Nat.

1st 24 hrs. after shot

Gas Cu. Ft.

Dry Hole

Abandoned

Date

OCT 24 1945

19

S. J. LEWIS

Scout