


Haskell County, Kansas

Section 30 Township 28S Range 31W

Well No. #1 Emmons Unit

Company Michaelis Dldg.

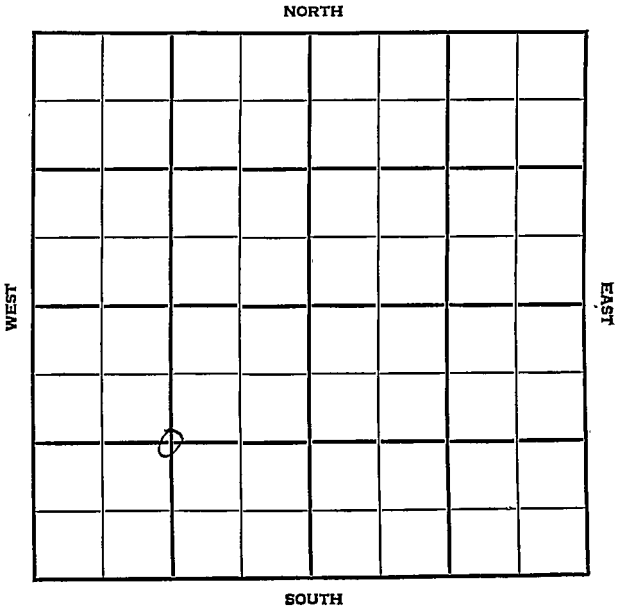

Haskell

KANSAS

SEC.	TWP.	R.
30	28	31W

WELL NO.

#1 Emmons Unit

FARM

COMPANY

Michaelis Drlg.

CONTRACTOR

Co. Tools

Hugoton


Ft. from N. Line

Ft. from S. Line

Ft. from E. Line

Ft. from W. Line

C SW/4

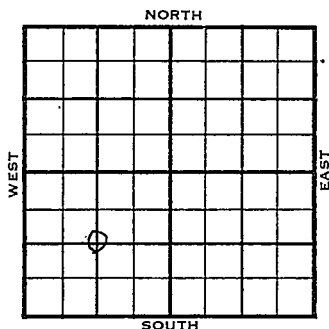

1955	ELEVATION	REPORT
	2920	
8/17	Comm 8-9-55 8" @ 555/300 5" @ 2771/300	TD 2772
10/12	Comm 8-9-55 8" @ 555/300 Herr 2686 U Kri 2712 L Kri 2742 TD 2772 5" @ 2771/300 CO to 2762 48/2742-54 48/2716-28 frac 1,178 mcfg SP 2734 365 mcfg Comp 1 mcfgpd	

COMPLETED

County Haskell Elev. 2920
 Sec. 30 Twp. 28 Rge. 31W
 Company Michaelis Drilg.
 Farm Name Emmons Unit No. 1

TOPS

DEPTH

LOG

DATUM

Loc. in Sec.

Anh.

C SW/4

Tp.

H.

Tr.

Dg.

Bl.

L.

K.C.

Geol.

B.K.C.

Contr.

Ce.

Co. tools

C.

M.

Pool

M.

K.

Hugoton

Mz.

Mg.

V.

S.

S.

A.

R.

P.E.

G.

T.D.

FIRST REPORT
 AUG 17 '55

Date Comm. 8-9-55

8" @ 555/300 TD 2772 5" @ 2771/300

[Handwritten signature]

County Haskell Elev. 2920
 Sec. 30 Twp. 28 Rge. 31W
 Company Michaelis Drlg.
 Farm Name Emmons Unit No. 1

TOPS	DEPTH	LOG	DATUM	Loc. in Sec.
Anh.				C SW/4
Tp.				
H. <u>Herr.</u>	<u>2686</u>			
Tr. <u>H. Kai.</u>	<u>2712</u>			
Dg. <u>H. Kai.</u>	<u>2742</u>			
Bl.				
L.				Geol.
K.C.				Contr.
B.K.C.				Co. tools
Ce.				Pool
C.				Hugoton
M.				
M.				
K.				
Mz.				
Mq.				
V.				
S.				
S.				
A.				
R.				
Pe.				
G.				
TD.	<u>2772</u>			

Date Comm. 8-9-55 OCT 1 2 1955

8" @ 555/300 TD 2772 5" @ 2771/300

GO to 2762 48/ 2742-54 48/ 2716-28

frac 1,178 mcfg SP 2734 365 mcfg

Comp. 1 mcfgpd

COMPLETE