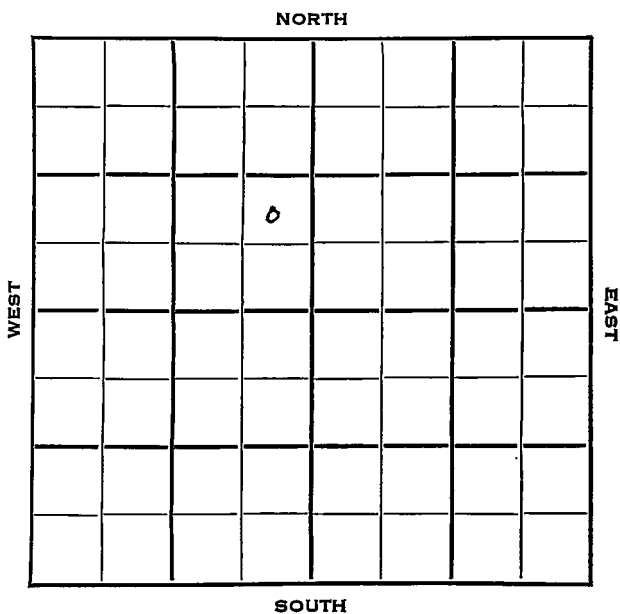


Section 30 Township 28 Range 14WWell No. #1 Eubank Estate "A"Company Lario Oil & Gas

Pratt

KANSAS

SEC. ~~10~~ ~~11~~ ~~12~~ TWP.

R.

30

28

1 1/4 W

WELL NO.

1 Eubank Estate "A"

FARM

COMPANY

Lario Oil & Gas

CONTRACTOR

Buick Drlg.

Wildcat

Ft. from N. Line

990 Ft. from S. Line

330 Ft. from E. Line

Ft. from W. Line

NE SE NW

NORTH

			0			

WEST

EAST

SOUTH

MCPC has SE of 29 1 mile EAST

ELEVATION

REPORT

1954

2037'

3/24

Spud 3-22-54

Drlg. 320'

4/1

Set 8" @ 361 w/250 sax.

Drlg. 2850'

(Ltr-McGehee)

4/7

Doug 3890', Br. L. 4001', Lans 4024'

DST 4068'-4101' 1 hr, 115' Hly gcm, 60'

O&GCM 120' Hly O&GCM 1409#

DST 4133'-48'

4/21

Spud 3-22-54

D & A

TD 4800'

8" @ 361'

Doug 3890', Br. Lime 4001', Lans 4024'

DST 4068'-4101' opn 1 hr, rec 115' hgcm

60' o & gcm 120' vho & gcm 1409#

DST 4133'-48' opn 1 hr, rec 135' Muddy

Wtr. 1380# Cong 4477',

DST 4480'-4520' opn 1 hr, rec 45' sgcm

1702# Viola 4548'

DST 4525'-45' gas in 6 min, 330,000

gas, 30' gcm 1540#

DST 4556'-4610' opn 3/4 hr, rec 10' Mud

40#

DST 4609'-50' opn 3/4 hr, rec 20' Mud

30# Simp sh 4646', Simp dolo 4650'

1954

Information brought forward.

4/21

Simp Sd 4680'

DST 4653'-92' opn $\frac{1}{2}$ hr, rec 2700' sw
1623# Arb 4762'

TD 4800'

D & A

ABANDONED

County **Pratt** State **Kansas**
 Sec. **30** (Blk. Twp.) **28** (Sur. Rge.) **14W** Map No.
 Operator **Lario Oil & Gas**
 Well No. **1** Farm **Eubank Estate "A"**
 Elev. Location **NE SE NW**

		0					

FIRST REPORT

990 Ft. From S Line NW
 330 Ft. From E Line Quarter
 MAR 24 1954
 1st. Report

Completion
 Remarks **MCPC has SE of 29**
Buick Drlg. - Contr.
 Spudding Date **3-22-54**

Drlg. Data **Wildcat**
drlg. 320

J. G. McGEHEE

MAR 25 1954

✓
Secret Cards MM

Land Small Map

Land Wan Map 33


Tracings

France Map

France Map

Notes

Orig. Data

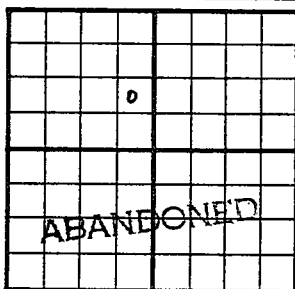County Pratt State KansasSec. 30 (Blk.) 28 (Sur. Rge.) 14W Map No. _____Operator Lario Oil & GasWell No. 1 Farm Eubank Estate "A"Elev. 2037 Location NE SE NW990 Ft. From S Line NW330 Ft. From E Line Quarter

1st. Report _____

Completion APR 21 1954Remarks WildcatBuick Drlg. - Contr.Spudding Date 3-22-54Drlg. Data D & A TD 48008" @ 361 Doug. 3890 Br. lime 4001Lans. 4024 DST 4068-4101 open 1 hr.Rec. 115' hgcm 60' o & gcm 120' vho & gcm1409# DST 4133-48 open 1 hr. Rec.135' muddy wtr. 1380# Cong. 4477DST 4480-4520 open 1 hr. - Rec. 45' sgcm1702# Viola 4548 DST 4525-45 gas in6 min. 330,000 gas 30' gcm 1540#DST 4556-4610 open 3/4 hr. Rec. 10' mud40# DST 4609-50 open 3/4 hr. Rec.20' mud 30# Simp. sh. 4646 Simp. dol.4650 Simp. sd. 4680 DST 4653-92open 1/2 hr. Rec. 2700' sw 1623#Arb. 4762 TD 4800D & AJ. G. McGEHEE

APR 27 1954

Local Cards

Land Survey Map

Field Wall Map

Tracings

Field Map

Pierce Map

Misc.

Drig. Data