

Kingman KANSAS


DX 78-1

Section 301 Township 28 Range 9W

Well No. 1 Murphy

Company J. H. & J. Oil Co. (Kansas City)

NORTH

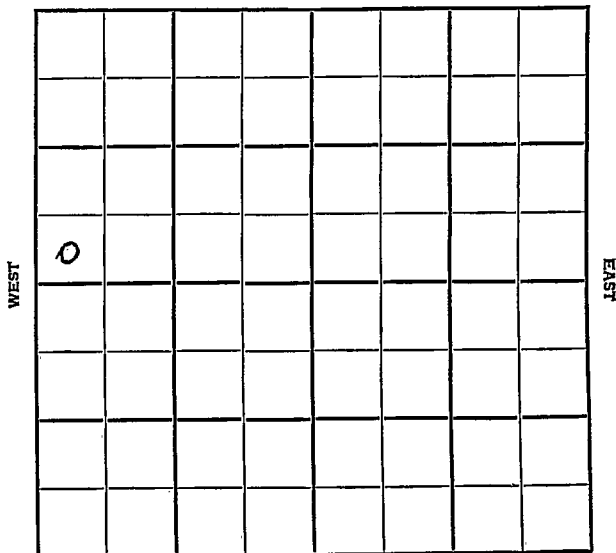

SOUTH

SEC. 30 TWP. 28 R. 9 W

WELL NO. # 1 Murphy FARM

COMPANY J. H. & J. Oil Co. (Kansas City) CONTRACTOR


Wildcat

Ft. from N. Line

330 Ft. from S. Line

Ft. from E. Line

330 Ft. from W. Line

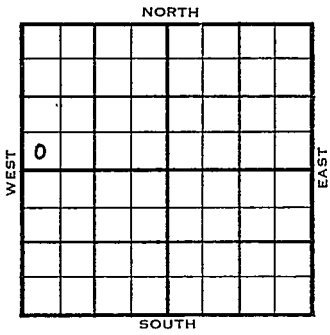

SW SW NW

Superior Ac. & DHM

ELEVATION	REPORT
195 1/4	
7/1 1/4	Location
8-18	Abd. location
	ABANDONED

