


Section 31 Township 28 Range 2 W

Well No. #1 Pauley

Company E. K. Carey

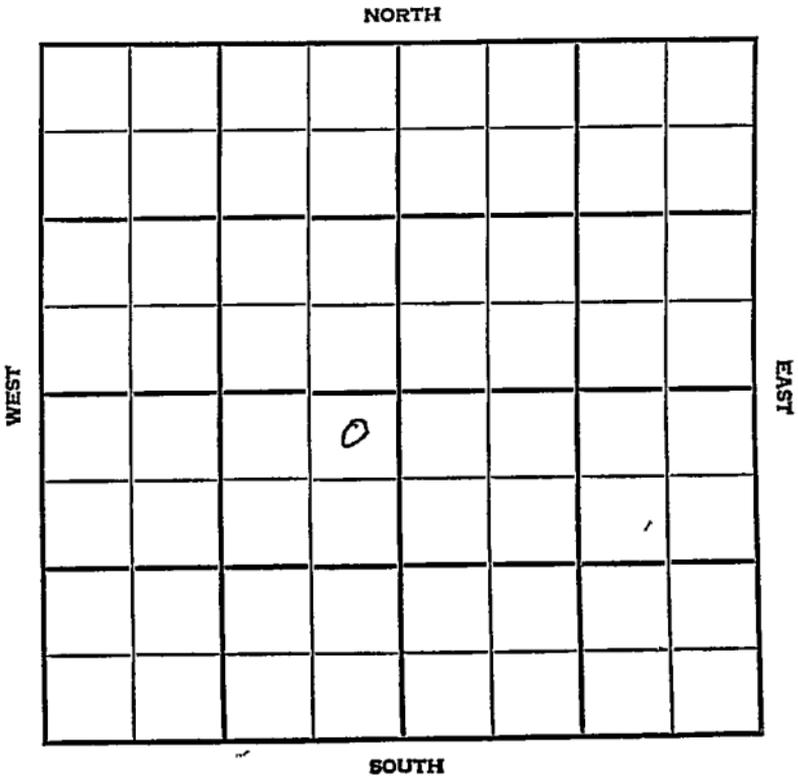

Sedgwick

KANSAS

SEC. 31	TWP. 28	R. 2W
------------	------------	----------

WELL NO. #1 Pauley FARM

COMPANY E.K.Carey

CONTRACTOR Co. tools


WILDCAT

\_\_\_\_\_ Ft. from N. Line

\_\_\_\_\_ Ft. from S. Line

\_\_\_\_\_ Ft. from E. Line

\_\_\_\_\_ Ft. from W. Line

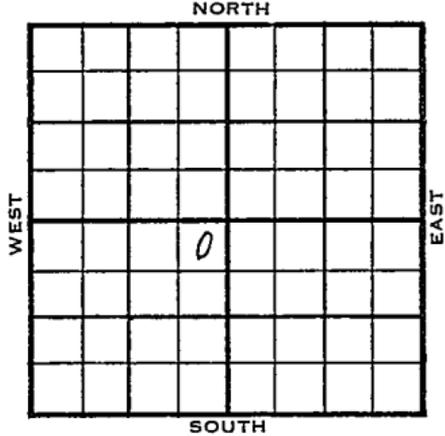

NE NE SW

1956	ELEVATION 1392	REPORT
------	-------------------	--------

2-22  
3-14

Location

Comm. 2-27-56  
8 5/8" @ 250  
D&A  
Stal 2832  
L. 3118  
M. 3736  
TD 3812'


ABANDONED



County Sedgwick Elev. 1392  
 Sec. 31 Twp. 28 Rge. 2W  
 Company E. K. Carey  
 Farm Name Pauley No. 1

TOPS	DEPTH	LOG	DATUM
Anb.			
Tr.			
H. <u>Stal</u>	<u>28.32</u>		<u>1440</u>
Tr.			
Dg.			
BL.			
L.	<u>3118</u>		<u>1726</u>
K.C.			
B.K.C.			
Ce.			
C.			
M.	<u>37.36</u>		<u>2544</u>
M.			
K.			
Mz.			
Ma.			
V.			
S.			
S.			
A			
R.			
PE.			
G.			
T.D.	<u>3812</u>		

Loc. in Sec. NE NE SW  
 Geol. \_\_\_\_\_  
 Contr. \_\_\_\_\_  
 Co. tools \_\_\_\_\_  
 Pool Wildcat

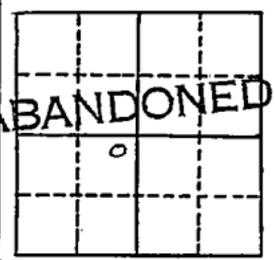

Date Comm. 2-27-56 MAR 1 4 1956  
8 5/8" @ 250

D & A

Co.  
 Lse.  
 No.  
 Sec.  
 T.  
 R.