


FORM 51 25M 3-49 PETROL Pratt

Section 31 Township 28 Range 12W

Well No. #1 Finchem


Company Pabco Drlg.

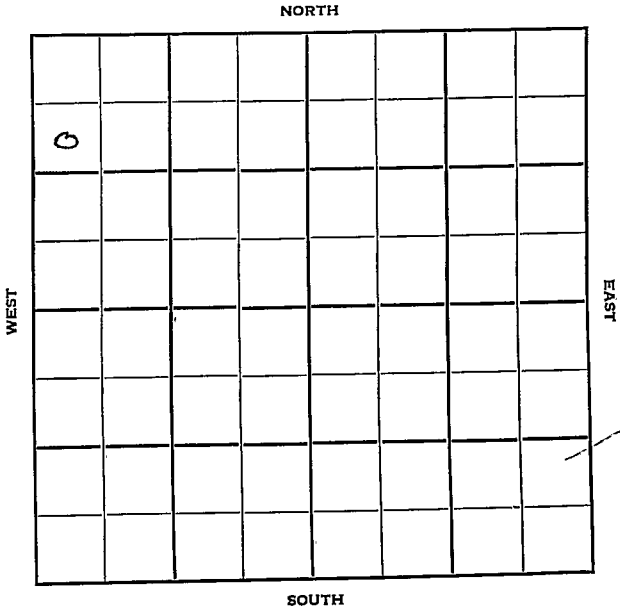

Sec. 31 Twp. 28 R. 12WWell No. #1 Finchem FarmPabco Drlg. CompanyPabco Drlg. ContractorWildcat990 Ft. from N. Line Ft. from S. Line Ft. from E. Line330 Ft. from W. Line

SW NW NW

Stanolind FO&DHM

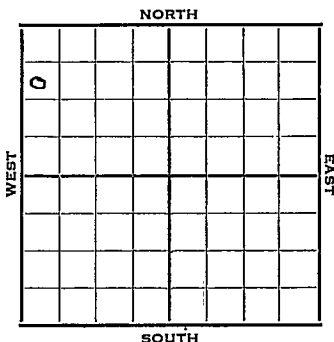

1952 Elev. 1914' REPORT

9/24 Spud 9-21-52
8" @ 300'10/1 Heeb. 3674
Drlg. 3965'


10/15 Spud Date: 9-21-52
Drlg. Data: D&A TD 4711'
8" @ 300
Heeb 3674, Br. Lime 3841, Lans
3868, Cong. 4344, Miss 4359
DST 4351-91, opn 1 hr., rec. 80' mud
Viola 4483, Simp. 4582, Arb 4702
DST 4703-11, opn 1 hr., rec. 1000'
sul. wtr.
TD 4711'
D&A

ABANDONED

County Pratt State KansasSec. 31 (Blk.) 28 (Sur.) 12W Map No.Operator Pabco Drlg.Well No. 7 Farm FinchemElev. Location SW 1/4 NW990 Ft. From N Line NW330 Ft. From W Line Quarter1st. Report SEP 24 1952

Completion

Remarks Stanolind farmout &Pabco Drlg. - Contr. ^{DHM}Spudding Date 9-21-52Drlg. Data Wildcat8" @ 300

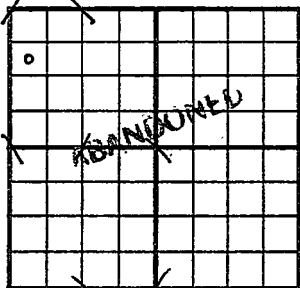County Pratt State KansasSec. 31 (Blk.
Twp.) 28 (Sur.
Rge.) 12W Map No.Operator Pabco Drlg.Well No. 1 Farm FinchemElev. 1914 Location SW NW NW990 Ft. From N Line NW330 Ft. From W Line Quarter

1st. Report

Completion OCT 15 1952Remarks WildcatPabco Drlg. - Contr.Spudding Date. 9-21-52Drlg. Data D & A TD 47118" @ 300 Heeb. 3674 Br. lime 3841Lans. 3868 Cong. 4344 Miss. 4359DST 4351-91 open 1 hr. Rec. 80' mudViola 4483 Simp. 4582 Arb. 4702DST 4703-11 open 1 hr. Rec. 1000' sul.water TD 4711D & A