


WELL PLUGGING RECORD

Give All Information Completely
Make Required Affidavit
Mail or Deliver Report to:
Conservation Division
State Corporation Commission
211 No. Broadway
Wichita, Kansas

Haskell County. Sec. 30 Twp. 28-S Rge. 32-W (E) (W)
Location as "NE/CNW/SE/SW" or footage from lines C sw - sw
Lease Owner Walter Kuhn Drig. Co.
Lease Name Masoner Well No. 1
Office Address 726-28 Union Center Bldg. Wichita, Kansas
Character of Well (completed as Oil, Gas or Dry Hole) Oil
Date well completed _____ 19____
Application for plugging filed _____ 19____
Application for plugging approved _____ 19____
Plugging commenced 10-23 19 63
Plugging completed 10-25 19 63
Reason for abandonment of well or producing formation Very poor well

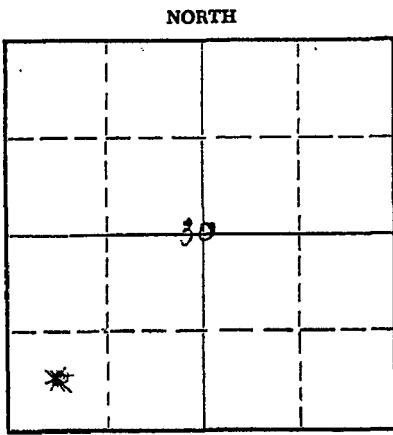

Locate well correctly on above Section Plat

If a producing well is abandoned, date of last production _____ 19____
Was permission obtained from the Conservation Division or its agents before plugging was commenced? Yes

Name of Conservation Agent who supervised plugging of this well Hugh Scott
Producing formation _____ Depth to top _____ Bottom _____ Total Depth of Well _____ Feet
Show depth and thickness of all water, oil and gas formations.

OIL, GAS OR WATER RECORDS

CASING RECORD

FORMATION	CONTENT	FROM	TO	SIZE	PUT IN	PULLED OUT
				8 5/8	2400	None
				5 1/2	5389	2603

Describe in detail the manner in which the well was plugged, indicating where the mud fluid was placed and the method or methods used in introducing it into the hole. If cement or other plugs were used, state the character of same and depth placed, from _____ feet to _____ feet for each plug set.
Pump 15 sacks cement 5389 to 5274 - mud to 2400 and pump 15 sacks cement at 2400 to 2285 Mud to 700 and pump 35 sacks cement 700' to 600'. Mud to 50' and 10' bridge, 15 sacks cement 40' to 0. Cut 8 5/8 casing off 3' below ground level and weld cap on same.

RECEIVED
STATE CORPORATION COMMISSION

NOV 1 1963

CONSERVATION DIVISION
Wichita, Kansas

(If additional description is necessary, use BACK of this sheet)

Name of Plugging Contractor Sargent's Casing Pulling Service
Address 121 West 9th St. Liberal, Kansas

STATE OF Kansas, COUNTY OF _____, ss. _____ (employee of owner) or (owner or operator) of the above-described well, being first duly sworn on oath, says: That I have knowledge of the facts, statements, and matters herein contained and the log of the above-described well as filed and that the same are true and correct. So help me God.

(Signature) Walter Kuhn

SUBSCRIBED AND SWORN TO before me this 25th day of October, 19 63

My commission expires May 16, 1967
Lucille Kerr Notary Public.