


DX 78-1

Sedgwick KANSAS

Section 32 Township 28 Range 2W

Well No. 1 Pelz

Company O. A. Sutton Corp.

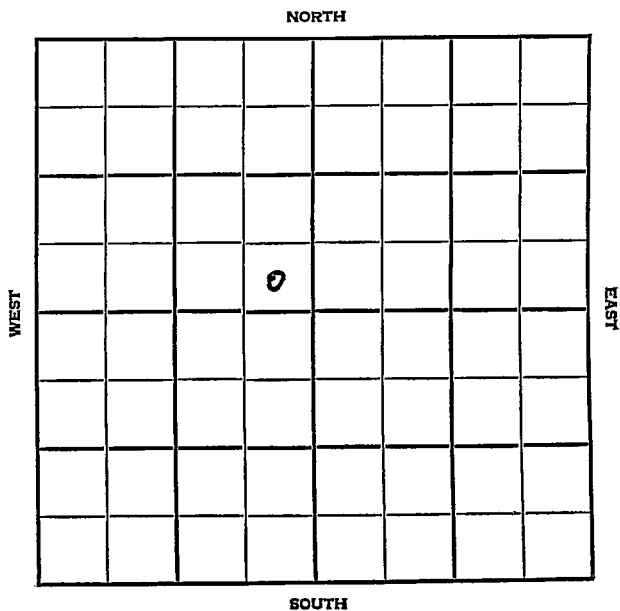

Sedgwick

Arkansas

SEC.	TWP.	R.
32	28	2W

WELL NO.

#1 Pelz

FARM

COMPANY

O. A. Sutton Corp

CONTRACTOR

Barnett


Wildcat.

Ft. from N. Line

Ft. from S. Line

330 Ft. from E. Line

Ft. from W. Line

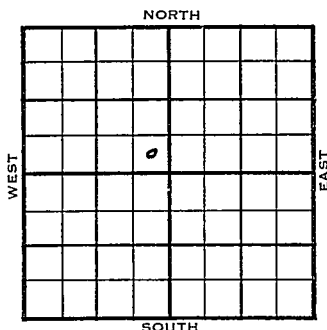

SE SE NW

Lion - DHM

ELEVATION

REPORT

1954

1386'

11/23

Spud 11-20-54
Drlg. 950'

12/15

Spud 11-20-54 D & A TD 4235
 8" @ 298 KC 3040
 DST 3105-28 open 1 hr rec 1020' SW
 1330# Miss 3656
 DST 3656-66 open 2 hr rec 60' VSO &
 GCM 75#
 DST 3660-76 open 2 hr rec 140' SO & GC
 440# DST 3700-46 open 1 hr rec 260'
 SMW 1295# Kh. 3983 Simp 4110
 Arb. 4207' TD 4235' D & A

ABANDONED

NOV 24 1954

Scout Cards
Land Scout Map
Land Wall Map
Y. ...
F. ...
P. ...
M. ...

1053

Drig. Data

County Sedgwick State Kansas

Sec. 32 (^{Blk.}_{Twp.}) 28 (^{Sur.}_{Rge.}) 2W Map No.

Operator O. A. Sutton Corp.

Well No. 1 Farm Pelz

Elev. 1386 Location SE SE NW

330 Ft. From S Line NW

330 Ft. From E Line Quarter

Ist. Report

Completion DEC 15 1954

Remarks Wildcat

Barnett - Contr.

Spudding Date 11-20-54

ABANDONED

Drlg. Data D & A TD 4235

8" @ 298 KC 3040 DST 3105-28

open 1 hr. Rec. 1020' sw 1330#

Miss. 3656 DST 3656-66 open 2 hr.

Rec. 60' vso & gcm 75# DST 3660-76

open 2 hr. Rec. 140' so & gcm 440#

DST 3700-46 open 1 hr. Rec. 260' smw

1295# Kh. 3983 Simp. 4110 Arb. 4207

TD 4235

D & A

FABEN GILSTRAP

Scout Cards	<i>mm</i>
Land Small Map	
Land Wall Map	<i>5</i>
Tracings	
France Map	
Piercé Map	
Other	

DEC 23 1954

Orig. Date