


Section 32 Township 28 Range 34W

Well No. 1 McCoy

Company United Prod.

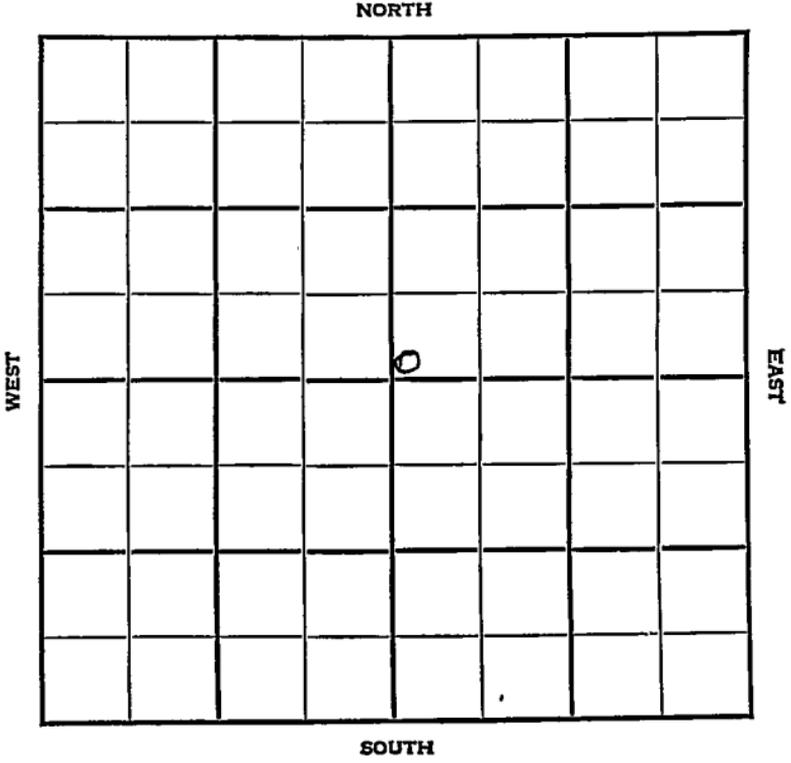

KANAS
KANE

Haskell

✓

Sec. 32 Twp. 28 R. 34-W

Well No. #1 McCoy Farm _____

 United Prod. Company

Hugoton Pool


_____ Ft. from N. Line

100' Ft. from S. Line

_____ Ft. from E. Line

100' Ft. from W. Line

SW NE

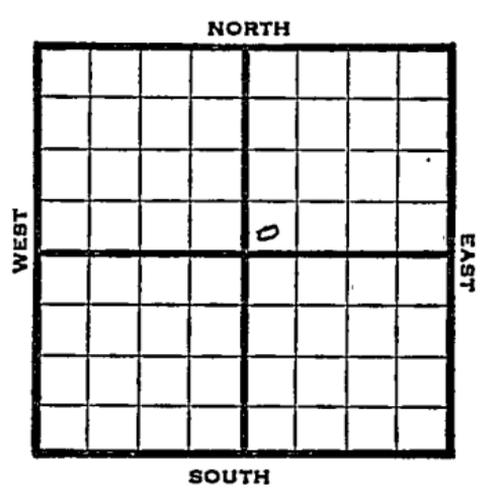

1947 REPORT
 Elev. 3006'

12/10	Location
12/17	10" @ 683' Drlg. 1998'
12/30	TD 2578' 7" @ 2563' RUST
1948	
1/7	TD 2775'
1/14	226' of 5" Perf liner @ 2775' 2000 acid
1/21	10,000 Acid
1/26	"
2/4	"
2/11	"
2/18	"
2/25	7" @ 2563' 226' of 5" perf. liner @ 2775' 12,000 acid 7,730,000 gas. 407# R. Pr. TD 2775' Comp.

COMPLETED

Map No. _____ Sec. 32 Twp. 28 R. 34W

Well No. 1 McCoy

United Prod. Company

-1ST REPORT Contractor

SW NE

SECTION PLAT

_____ Ft. from N. Line

100 Ft. from S. Line

_____ Ft. from E. Line

100 Ft. from W. Line

Haskell County

Location X

Rig up _____

Drilling and Remarks:

RECORD

Cased _____ in., _____ ft.

Sand _____

Gas _____

Oil _____

Total Depth _____

PRODUCTION

1st 24 hrs. Nat. _____

1st 24 hrs. after shot _____

Gas _____ Cu. Ft.

Dry Hole _____

Abandoned _____

Date

DEC 10 1947

19

S. J. LEWIS

Scout

Map No. No Map Sec. 32 Twp. 28 R. 34W

Well No. 1 McCoy

United Prod. Company

COMPLETE

Contractor

E. 3006

SW NE

SECTION PLAT

 Ft. from N. Line

100 Ft. from S. Line

 Ft. from E. Line

100 Ft. from W. Line

		0	

Haskell County

Location

Rig up

Drilling and Remarks:

7" @ 2563

226' of 5" Perf Lines

@ 2775-

12000 @ ash

7, 730, 000 Gall

402 # RA

RECORD

Cased in., ft.

Sand

Gas

Oil

Total Depth 2775'

PRODUCTION

1st 24 hrs. Nat.

1st 24 hrs. after shot

Gas Cu. Ft.

Dry Hole

Abandoned

Date

FEB 25 1948 19

S. J. LEWIS Scout