


Section 32 Township 28 Range 32W

Well No. 1 Poor Farm

Company Huber Corporation

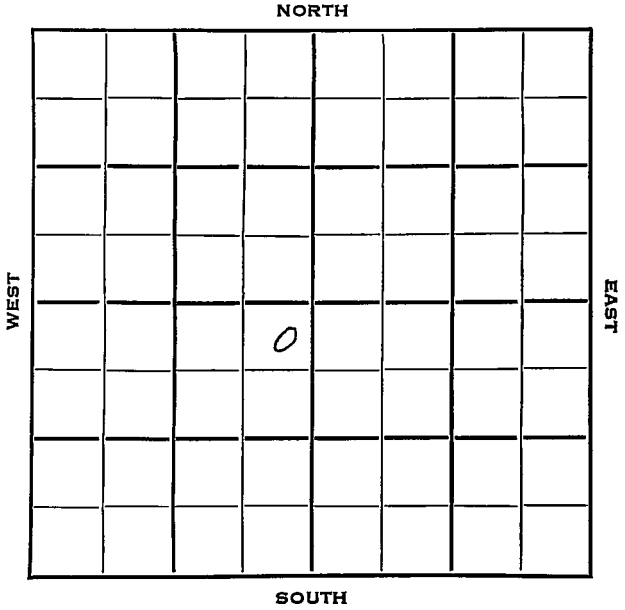

Sec. 32 Twp. 28 R. 32W

Well No. #1 Poor Farm Farm

Huber Corporation Company


Contractor

150 Ft. from N. Line

_____ Ft. from S. Line

150 Ft. from E. Line

_____ Ft. from W. Line

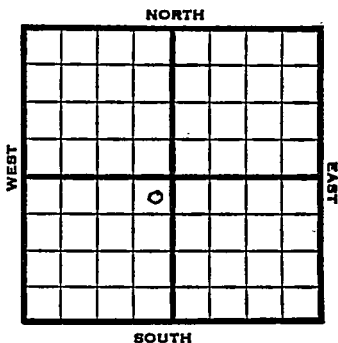

NE SW

1953 Elev. 2923' REPORT

3/14 Spudded 3/1/53
8" @ 600 Drlg. 2485

3/12 RTD 2660
5" @ 2660

3/19 Pipe trouble

3/26 DD 2745'

4/2 DD 2770 1500A

4/9 "

4/16 NR

4/22 Spud 3-1-53
Gas Well
TD 2770'
8" @ 600'
Her 2604, Kri 2649
TD 2660
5" @ 2660'

DD 2700 9000 A DD 2733 60 qt/
2708-33 DD 2745 DD 2770 1500 A
Comp. 2,430,000 gas 400#

COMPLETED

County Haskell State Kansas

Sec. 32 (^{Blk.}Twp.) 28 (^{Sur.}Rge.) 32W Map No.

Operator Huber Corp.

Well No. 1 Farm Poor Farm

Elev. _____ Location NE SW

FIRST REPORT					
		0			

150 Ft. From N Line SW

150 Ft. From E Line Quarter

1st. Report MAR 4 1953

Completion _____

Remarks _____

Spudding Date 3-1-53

Drlg. Data _____

8" @ 600 drlg. 2485

Scout Cards
1st State Map
Land Wall Map
Maines
France Map
Pierce Map
Misc

MAR 6

1901

APR 28 1952

Scout Cards	PP
Land Small Map	
Land Wall Map	52
Tracings	
France Map	
Merce Map	
Misc.	