


Pratt - KANSAS

DX 78-1

Section 32 Township 28 Range 13W

Well No. 1 McMinn

Company Lion Oil & Rine Drlg.

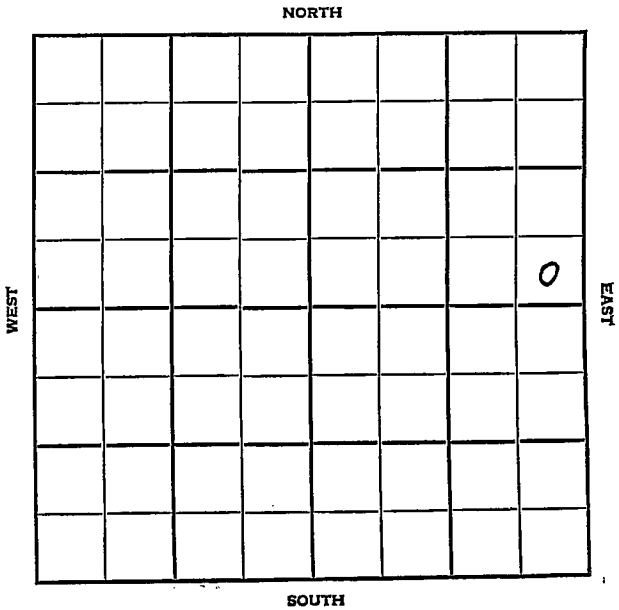

Pratt KANSAS

SEC.	TWP.	R.
32	28	13W ✓

WELL NO.

1 McMinn

FARM


COMPANY

Lion Oil & Rine Drlg.

CONTRACTOR

Rine Drlg.

_____ Ft. from N. Line
330 _____ Ft. from S. Line
330 _____ Ft. from E. Line
 _____ Ft. from W. Line

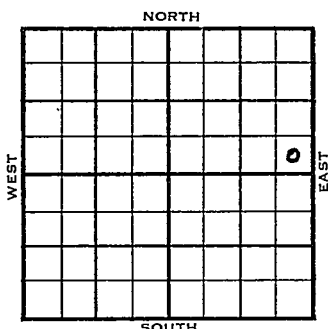

SE SE NE

1954	ELEVATION 1958'	REPORT
6/30	M I R	
7/7	8" @ 433'	
	Drlg. 3485'	
7/21	Spud 6-29-54	
	D&A	
	TD 4615'	
	8" @ 433'	
	Heeb 3705', Doug. 3784', Br lime	
	3908', Lans 3920'	
	DST 4037-45', opn 1 hr., rec. 80' muddy	
	wtr, 1350#	
	DST 4051-85', opn 1 hr., rec. 335' SW	
	1400#	
	DST 4238-80', opn 1 hr., rec. 5' mud,	
	56#	
	Miss 4381'	
	DST 4335-91', opn 1 hr., rec. 20' mud,	
	0#	
	Viola 4413'	
	DST 4436-44, opn 3/4 hrs., rec. 30' mud	
	0#	
	Simp. 4485'	
	DST 4482-4533', opn 1 1 1/2 hrs., rec. 40'	
	mud; 96#	
	Arb. 4581'	
	DST 4582-90', opn 1 hr., rec. 245'	
	SO&GCM, 190# - TD 4615'	
	D&A	ABANDONED

County **Pratt** State **Kansas**Sec. **32** (Bk. Twp.) **28** (Sur. Rge.) **13W** Map No.Operator **Lion Oil & Rine Drlg.**Well No. **1** Farm **McMinn**Elev. Location **SE SE NE**

FIRST REPORT

330 Ft. From **S** Line **NE****330** Ft. From **E** Line Quarter1st. Report **JUN 30 1954**


Completion

Remarks

Rine Drlg. - Contr.

Spudding Date

Drlg. Data **Wildcat****M I R****J. G. McGEHEE**

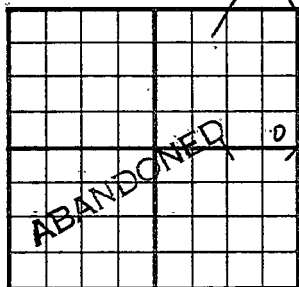County Pratt State KansasSec. 32 (Blk. Twp.) 28 (Sur. Rge.) 13W Map No.Operator Lion Oil & Rine Drlg.Well No. 1 Farm McMinnElev. 1958 Location SE SE NE330 Ft. From S Line NE330 Ft. From E Line Quarter

1st. Report

Completion JUL 21 1954Remarks WildcatRine Drlg. - Contr.Spudding Date 6-29-54Drlg. Data D & A TD 46158" @ 433 Heeb. 3705 Doug. 3784Br. lime 3908 Lans. 3920 DST 4037-45open 1 hr. Rec. 80& muddy wtr. 1350#DST 4051-85 open 1 hr. Rec. 335' sw1400# DST 4238-80 open 1 hr. Rec.5' mud 56# Miss. 4381 DST 4335-91opne 1 hr. Rec. 20' mud 0#Viola 4413 DST 4436-44 open 3/4 hr.Rec. 30' mud 0# Simp. 4485DST 4482-4533 open 1 1/2 hr. Rec. 40' mud96# Arb. 4581 DST 4582-90 open 1 hr.Rec. 245' so & gcm 190# TD 4615D & A

J. G. McGEHEE