



FORM 51 **Haskell** **KANSAS**
Section 25 Township 28 Range 33W
Well No. #1 Cave
Company Huber Corporation

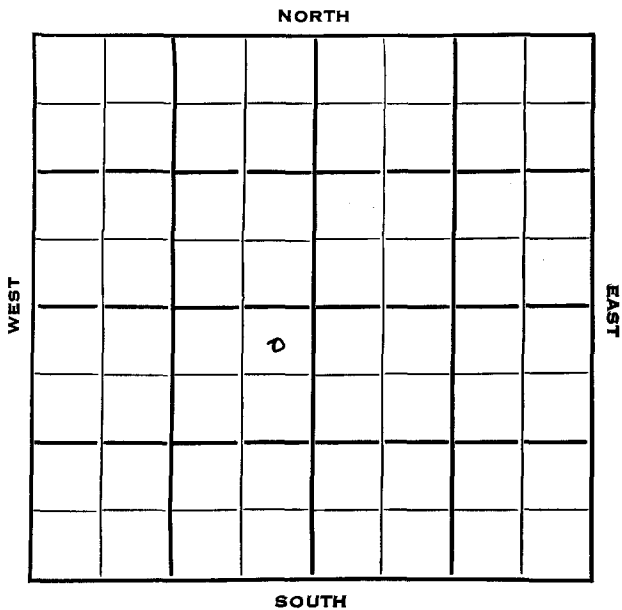

FORM 252-B **Haskell** **KANSAS** ✓
Sec. 25 Twp. 28 R. 33W
Well No. #1 Cave Farm _____
Huber Corp. Company _____
Contractor _____


150 Ft. from N. Line
_____ Ft. from S. Line
150 Ft. from E. Line
150 Ft. from W. Line

NE SW

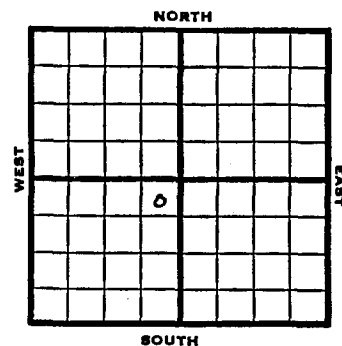


1953	Elev. 2943' REPORT
2/18	Spudding Date 2/14/53 8" @ 600 Drlg. 1480
2/26	RTD 2720 5" @ 2714 DD 2731 1000 Dol-Frac
3/12	60/2642-62, 144/2664-88, 6000A Her 2617, Up Kr 2643, Low Kr 2664, Win 2719
3/19	NR
3/26	NR
4/1	Spud 2-14-53 Gas well TD 2731 8" @ 600 TD 2720 5" @ 2714 DD 2731 1000 dol-frac. 60/2642-62 144/2664-88 6000 A Her. 2617' Kri. 2643' Win. 2719' Comp. 3,970,000 gas.

COMPLETED

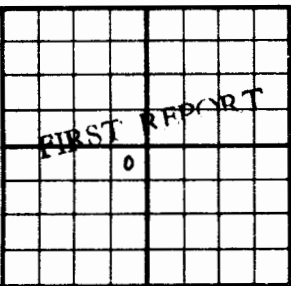County	Haskell		State	Kansas	
Sec.	25	(Blk. Twp.) 28	(Sur. Rge.) 33W	Map No.	
Operator	Huber Corp.				
Well No.	1 Farm Cave				
Elev.	Location NE SW				
		150 Ft. From N Line SW			
		150 Ft. From E Line Quarter			
		1st. Report FEB 1 8 1953			
		Completion			
		Remarks			
		Spudding Date 2-14-53			
Drlg. Data					
8" @ 600 drlg. 1480					

J. G. McGEHEE

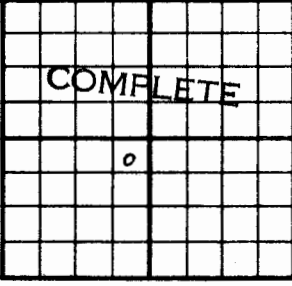County	Haskell		State	Kansas	
Sec.	25	(Blk. Twp.) 28	(Sur. Rge.) 33W	Map No.	
Operator	Huber Corp.				
Well No.	1 Farm Cave				
Elev.	Location NE SW				
		150 Ft. From N Line SW			
		150 Ft. From E Line Quarter			
		1st. Report			
		Completion APR 1 1953			
		Remarks			
		Spudding Date 2-14-53			
Drlg. Data Gas well TD 2731					
8" @ 600 TD 2720 5" @ 2714 DD 2731					
1000 dol-frac 60/ 2642-62 144/ 2664-88					
6000 A Her. 2617 Kri. 2643					
Win. 2719 Comp. 3,970,000 gas					

J. G. McGEHEE