
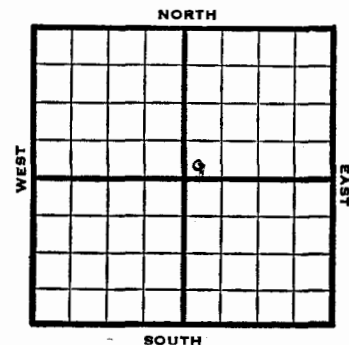


Section 35 Township 28 Range 33-WWell No. #1 JonesCompany National Assoc. Pet.Sec. 35 Twp. 28 R. 33WWell No. #1 Jones FarmNational Assoc. Pet. CompanyBurris - Contr. ContractorHugoton Pool100' Ft. from N. Line100' Ft. from S. Line100' Ft. from E. Line100' Ft. from W. Line

SW NE

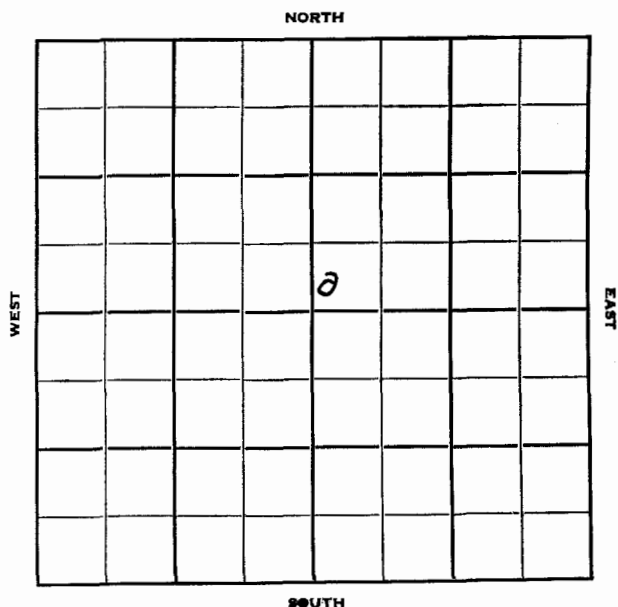


1950 Elev. 2956' REPORT

11/15 Spud 11-12-50
10" @ 688'
WOC1951
2/7

Spud 11-12-50
 Gas well TD 2757
 10" @688 5" @2735 TD 2757
 396/ 2658-2704
 Her. 2655 Krider 2681 Win. 2732
 22000 A Comp. 7,435,000 gas
COMPLETED

County **Haskell** State **Kansas**
 Sec. **35** (Blk. Twp.) **28** (Sur. Rge.) **3 3W** Map No.
 Operator **National Assoc. Pet.**
 Well No. **1** Farm **Jones**
 Elev. **2956** Location **SW NE**

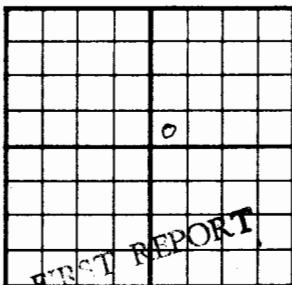


100 Ft. From **S** Line **NE**
100 Ft. From **W** Line **Quarter**
 Ist. Report **NOV 15 1950**
 Completion
 Remarks
Burris - Contr.
 Spudding Date **11-12-50**

Drlg. Data **Hugoton Pool**

10" @ 688 WOC

J. E. TYRA

County **Haskell** State **Kansas**
 Sec. **35** (Blk. Twp.) **28** (Sur. Rge.) **33W** Map No.
 Operator **National Assoc. Pet.**
 Well No. **1** Farm **Jones**
 Elev. **2956** Location **SW NE**

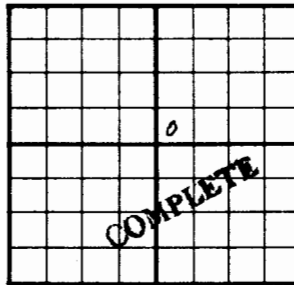

100 Ft. From **S** Line **NE**
100 Ft. From **W** Line **Quarter**
 Ist. Report
 Completion **FEB 7 1951**
 Remarks **Hugoton Pool**
Burris - Contr.
 Spudding Date **11-12-50**

Drlg. Data **Gas well TD 2757**

10" @ 688 5" @ 2735 TD 2757

396/ 2658-2704 Her. 2655- Krider 2681

Win. 2732 22000 A Comp. 7,435,000 gas

J. E. TYRA