
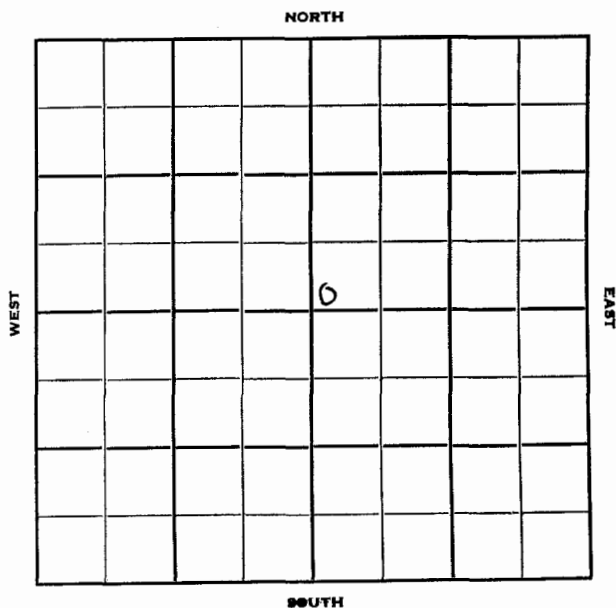


Section 24 Township 28 Range 33-WWell No. #1 SealeyCompany National Assoc. Pet.Sec. 24 Twp. 28 R. 33WWell No. #1 Sealey FarmNational Assoc. Pet. CompanyBurris - Contr. ContractorHugoton PoolFt. from N. Line100' Ft. from S. LineFt. from E. Line100' Ft. from W. Line

SW NE

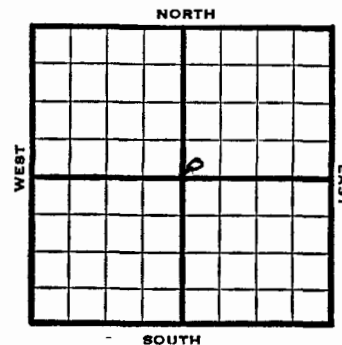

1950

Elev. 2948 REPORT

11/15

Spud 11-11-50

13" @ 565'

WOC

1951

2/7

Spud 11/11/50

Gas well TD 2750

13" @ 565 5" @ 2726 TD 2750

152/ 2656-98

Her. 2649 Krider 2676 Win 2724

19000 A Comp. 8,520,000 gas

CONTINUED

County	Haskell		State	Kansas				
Sec.	24	(Blk. Twp.) 28	(Sur. Rge.) 33W	Map No.				
Operator	National Assoc. Pet.							
Well No.	1	Farm	Sealey					
Elev.	Location		SW NE					
FIRST REPORT								
						100 Ft. From S Line	NE	
						100 Ft. From W Line	Quarter	
						1st. Report	NOV 15 1950	
						Completion		
Remarks	Burris - Contr.							
Spudding Date	11-11-50							
Drig. Data	Fugoton Pool							
13" @ 565 WCC								

J. E. TYRA

County	Haskell		State	Kansas				
Sec.	24	(Blk. Twp.) 28	(Sur. Rge.) 33W	Map No.				
Operator	National Assoc. Pet.							
Well No.	1	Farm	Sealey					
Elev.	2948		Location SW NE					
COMPLETE								
						100 Ft. From S Line	NE	
						100 Ft. From W Line	Quarter	
						1st. Report		
						Completion	FEB 7 1951	
Remarks	Hugoton Pool							
	Burris - Contr.							
Spudding Date	11-11-50							
Drig. Data	Gas well TD 2750							
13" @ 565 5" @ 2726 TD 2750								
152/ 2656-98 Her. 2649 Krider 2676								
Win. 2724 19000 A Comp. 8,520,000 gas								

J. E. TYRA