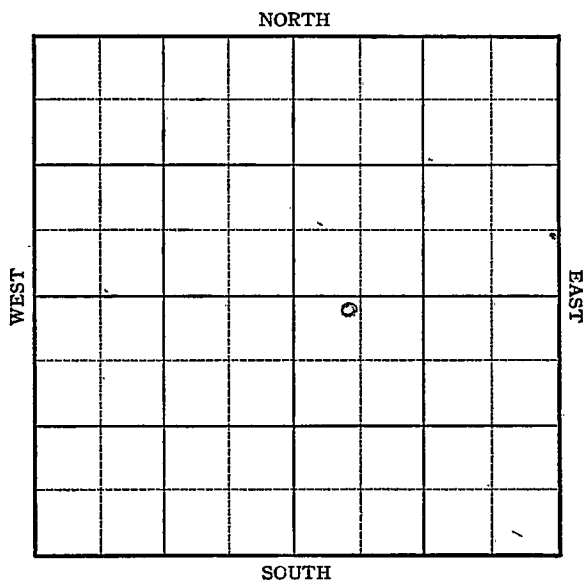


KANSAS

Haskell

Section 33 Township 28 Range 33WWell No. #1 RandelCompany Helmerick & Payne

KANSAS

Haskell

Sec. 33 Twp. 28 R. 33W

Well No. #1 Randel Farm

Helmerick & Payne Company

Hugoton


100 Ft. from N. Line

 Ft. from S. Line

100 Ft. from E. Line

 Ft. from W. Line

NW SE Elev. 2963

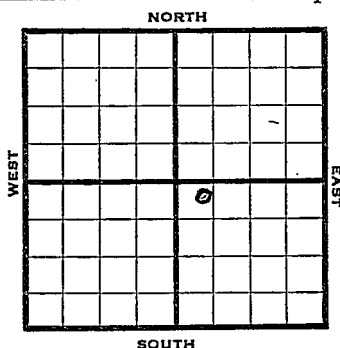

1945

R E P O R T

2/28	10 @ 760 WOC
3/7	Drlg 2210
3/14	5" @ 2779
	TD 2780 RUST
3/23	" " "
3/29	" " "
4/5	" " "
4/12	" " "
4/20	" " "
4/27	" " "
5/3	" " "
5/10	" " "
5/17	" " "
5/24	" " "
5/31	" " "
6/8	" " "
6/14	" " "
6/21	" " "
6/28	40 shots to 2720-40 500 acid
7/3	36 shots 2662-2664 500 acid.
7/11	10000 acid.
7/19	" "
7/26	" "
8/1	" "
8/8	" "
8/15	" "
8/22	" "
8/29	" "

OVER

1945

9/5 Total 28000 acid

9/12 " " "

9/19 " " "

9/26 " " "

10/3 " " "

10/10 " " "

10/24 5" @ 2779

2800 acid.

Perf.

TD 2780

5,723,000 Gas.

420# R Pr.


COMPLETED

Pool Name HugotonMap No. NM Sec. 33 Twp. 28 R. 33WWell No. 1 RandelHelmerick & Payne Company

FIRST REPORT

NW SE Contractor

SECTION PLAT

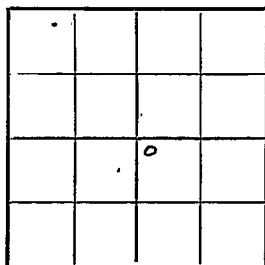100 Ft. from N. Line Ft. from S. Line100 Ft. from E. Line Ft. from W. Line

Haske 11

Location Rig up

Drilling and Remarks:

10-760 WOC

RECORD

Cased in., ft.Sand Gas Oil Total Depth

PRODUCTION

1st 24 hrs. Nat. 1st 24 hrs. after shot Gas Cu. Ft.Dry Hole Abandoned

Date

FEB 28 1945

19

S. J. LEWIS

Scout

no wall map

Misc Small Maps	<i>LR</i>
Cards	<i>pretty</i>
Tracing	
France Map	
Scarborough Map	<i>LR</i>
Pierce Map	
Geological Dept.	
Pierce Plat Book	

KANSAS Pool Name Hugoton
 Map No. 20 Sec. 33 Twp. 28 R. 33W
 Well No. 1 Randel

Helmerick & Payne Company

COMPLETED

Contractor

NW SE


E1.2963
SECTION PLAT

100 Ft. from N. Line

 Ft. from S. Line

100 Ft. from E. Line

 Ft. from W. Line

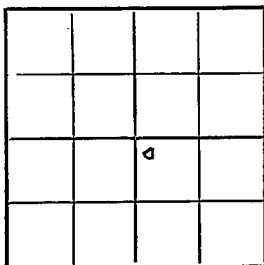

Haskell County

RECORD

Location

Cased in., ft.

Rig up

Sand

Drilling and Remarks:

Gas

5" 02779

Oil

2800 oil

Total Depth 2780

Perf.

PRODUCTION

5,723,000 Gas

1st 24 hrs. Nat.

1st 24 hrs. after shot

Gas Cu. Ft.

Dry Hole

Abandoned

420 # R/P

Date

OCT 24 1945

19

S. J. LEWIS

Scout

Misc. Small Maps

Cards

Tracing

France Map

Scarborough Map

Moody Map

Geological Dept.

Moody Plat Book