


DX 78-1 Haskell

KANSAS

Section 33 Township 28 Range 32W

Well No. #1 Wheatley

Company Graham-Michaelis

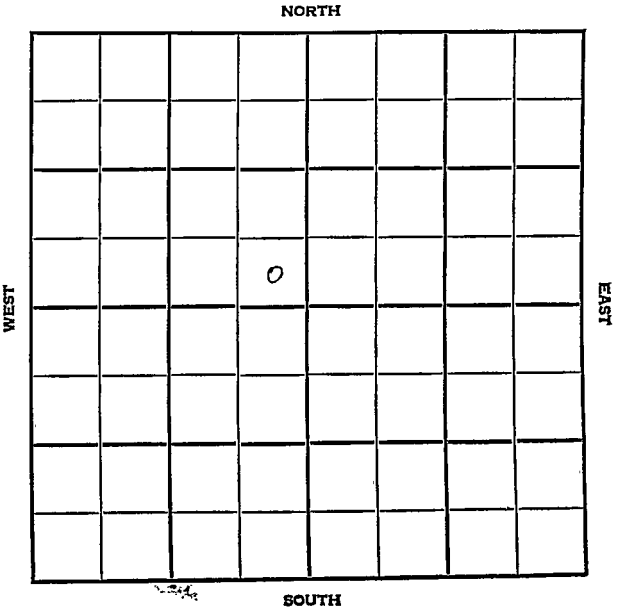

SEC. 33	TWP. 28	R. 32W
------------	------------	-----------

WELL NO. #1 Wheatley FARM

COMPANY Graham-Michaelis

CONTRACTOR


Hugoton

_____ FT. FROM N. LINE

150 _____ FT. FROM S. LINE

150 _____ FT. FROM E. LINE

_____ FT. FROM W. LINE

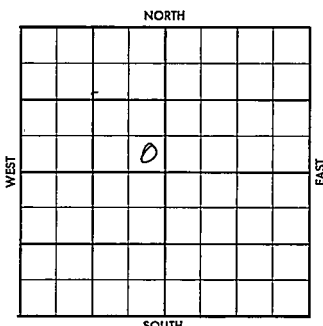

SE SE NW

Stanolind - FO

1956	ELEVATION	REPORT
------	-----------	--------

8-8 Comm. 7-31-56
7" @ 549 w/150

County Haskell Elev. _____
 Sec. 33 Twp. 28 Rgs. 32W
 Company Graham-Michaelis
 Farm Name Wheatley No. 1

TOPS	DEPTH	LOG	DATUM
Anh.			
TP.			
H.			
Tr.			
Dg.			
Bl.			
L.			
K.C.			
B.K.C.			
Ce.			
C.			
M.			
M.			
K.			
Mz.			
Mo.			
V.			
S.			
S.			
A.			
R.			
PE.			
G.			
T.D.			

Loc. in Sec. _____
SE SE NW
150' SL
150' EL
 Geol. _____
 Contr. _____
 Pool
Hugoton

FIRST REPORT

o

--- AUG 8 - 56 ---

Date Comm. 7-31-56 Stanolind - FO
7" @ 519/150

8001 1000

[Handwritten signature]

Co. Lse. No. Sec. T. R.

County **Haskell** Elev. **2730**
 Sec. **33** Twp. **28** Rge. **32W**
 Company **Graham-Michaelis**
 Farm Name **Wheatley** No. **I**

TOPS	DEPTH	LOG	DATUM	Loc. in Sec.						
Ant. H&H		2614		SE SE NW.						
Tr. U&H		2643								
H. N. K&L		2668		150' SL						
Tr. U&H		2724		150' EL						
Dg.										
Bl.				Geol. _____						
L.										
K.C.				Contr. _____						
B.K.C.										
Ce.				Pool Hugoton						
C.										
M.				<table border="1"> <tr> <td colspan="2">COMPLETE</td> </tr> <tr> <td></td> <td>0</td> </tr> <tr> <td></td> <td>OCT 31 '55</td> </tr> </table>	COMPLETE			0		OCT 31 '55
COMPLETE										
	0									
	OCT 31 '55									
M.										
K.										
Mz.										
Ms.										
V.										
S.										
A.										
R.										
PE.										
G.										
TR	2727									

Date Comm. **7-31-56** Stanolind - FO

7" @ 549/150 AUG 15 '56
WOR AUG 22 '56 AUG 29 '56 SEP 5 '56
 SEP 12 '56 SEP 19 '56 **WOR** SEP 26 '56 **2720**
 OCT 3 '56 **4 1/2 @ 2726/450** OCT 10 '56
 OCT 17 '56 **4 / 2714-15 sod.**
32/2646-54 88/2670-92
FRAC 9a 500 MCF @ 9a 1,300
MCF @ 9a 1,300 MCF. OCT 24 '56
 OCT 31 '56 **72-20 4,223 MCF RP 406**