


Section 33 Township 28 Range 16 W

Well No. #1 Kuhn

Company Murfin Drlg.

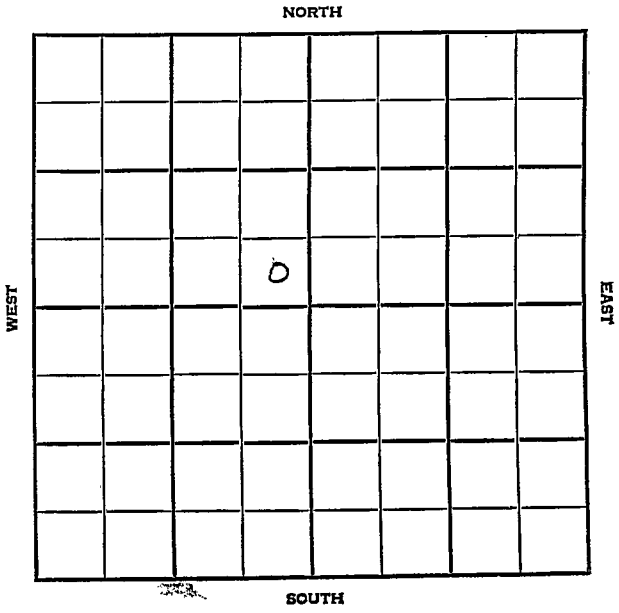


SEC.	TWP.	R.
33	28	16W

WELL NO. #1 Kuhn FARM

COMPANY Murfin Drlg.

CONTRACTOR

_____ Ft. from N. Line
 _____ Ft. from S. Line
 _____ Ft. from E. Line
 _____ Ft. from W. Line

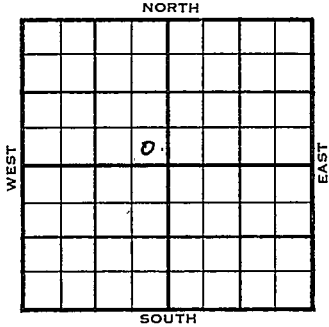

SE SE NW

	ELEVATION	REPORT
1955	2094'	

10/12 M I R

11/2 Comm 10-13-55
 8 5/8" @ 395/250
 DST 4679-4719 open 1 hr rec 62' mud
 0/20" D&A

ABANDONED

County Kiowa Elev. 2094
 Sec. 33 Twp. 28 Rge. 16W
 Company Murfin Drlg.
 Farm Name Kuhn No. 1

TOPS	DEPTH	LOG	DATUM
Anb.			
Tp.			
H.	<u>3984</u>		<u>1890</u>
Tr.			
Dg. <u>ski</u>	<u>4015</u>		<u>1921</u>
Bl.	<u>4146</u>		<u>2052</u>
L.	<u>4162</u>		<u>2068</u>
K.C.			
B.K.C.	<u>4483</u>		<u>2389</u>
Ce.			
C.	<u>4678</u>		<u>2584</u>
M. <u>rework</u>	<u>4690</u>		<u>2596</u>
M. <u>lime</u>	<u>4707</u>		<u>2613</u>
K.	<u>4725</u>		<u>2628</u>
Mz.			
Mq.			
V.	<u>4763</u>		<u>2669</u>
S.			
S.			
A.			
R.			
PE.			
G.			
T.D.	<u>4800</u>		

Loc. in Sec. SE SE NW

Geol.

Contr.

Pool

ABANDONED

Date Comm. 10-13-55 NOV 2 1955

8 5/8" @ 395/250 DST 4679-4719

open 1 hr. rec. 62' mud 0/20"

D & A

Co.

Use.

No.

Sec.

T.

R.

County Knows Elev. _____
 Sec. 33 Twp. 28 Rge. 16W
 Company Murfin Drlg.
 Farm Name Kuhn No. 1

TOPS	DEPTH	LOG	DATUM	Loc. in Sec.
Anh.				SE SE NW
Tp.				
H.				
Tr.				
Dg.				
Bl.				
L.				Geol. _____
K.C.				Contr. _____
B.K.C.				
Ce.				
C.				
M.				Pool _____
M.				
K.				
Mz.				
Ma.				
V.				
S.				
S.				
A.				
R.				
Pe.				
G.				
T.D.				

OCT 12 '55
 o
FIRST REPORT

Date Comm. M I R

[Handwritten signature]

Co.
Lse.
No.
Sec.
T.
R.