
FORM 51 5M BRIX KANSAS Pratt County

Section 33 Township 28 Range 11W

Well No. #1 Schroeder

Company Anderson & Prichard

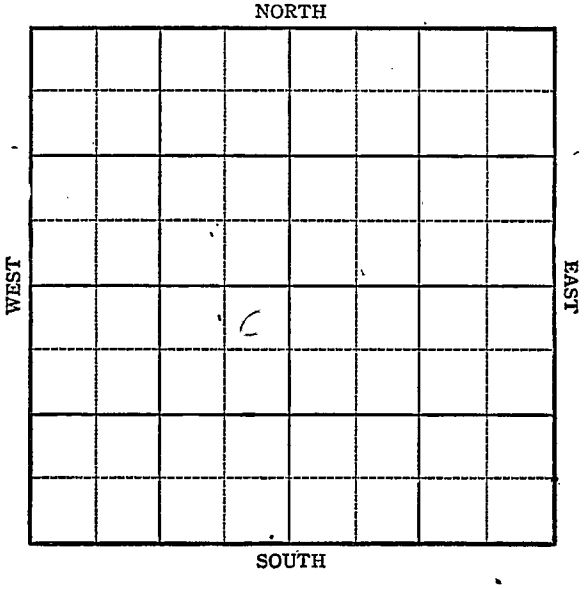

FORM 252-A
5M 9-44 PETROL

Special

KANSAS

Pratt County

Sec. 33 Twp. 28 R. 11W

Well No. #1 Schroeder Farm

Anderson & Richard Company


Wildcat

330 Ft. from N. Line

Ft. from S. Line

330 Ft. from E. Line

Ft. from W. Line

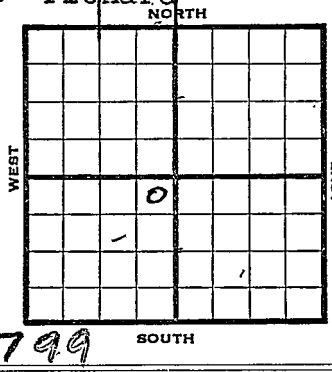

NE SW Elev. 1799

1944	REPORT
10/4	Location
10-10	Cellar
10-17	10" @ 362' Waiting on cement.
10-25	Drilling 2476'
11-1	Drilling 3285'
11-8	Drilling 4045'
11-15	Lansing 3685' Mississippi 4174' Viola 4384 Simpson 4480 Drilling 4515'
11/22	Arb. 4569' TD 4610'

4480
1799
2681

ABANDONED

FORM 26 200 BKS. 2-44 PETROL

KANSAS Pool Name Wildcat

Map No. 54 Sec. 33 Twp. 28 R. 11W


Well No. 1 Schroeder

Anderson & Prichard Company

FIRST REPORT Contractor

NE SW

SECTION PLAT

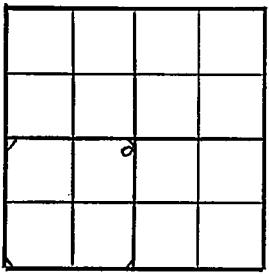

330 Ft. from N. Line

Ft. from S. Line

330 Ft. from E. Line

Ft. from W. Line

Pratt

Location X

Rig up

Drilling and Remarks:

Hot File

RECORD

Cased in, ft.

Sand

Gas

Oil

Total Depth

PRODUCTION

1st 24 hrs. Nat.

1st 24 hrs. after shot

Gas Cu. Ft.

Dry Hole

Abandoned

Date

OCT 4 1944 19

S. J. LEWIS Scout

FORM 26 200 BKS 1-44 PETROL

Pool Name Wildcat

Map No. 54 Sec. 33 Twp. 28 R. 11W

Well No. 1 Schroeder

Anderson & Prichard Company

ABANDONED Contractor

NE SW


330 Ft. from N. Line

Ft. from S. Line

330 Ft. from E. Line

Ft. from W. Line

SECTION PLAT

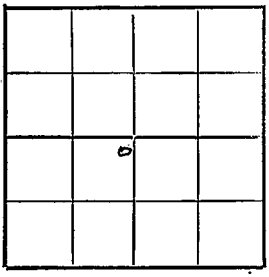

Pratt

Location

Rig up

Drilling and Remarks:

Cir # 4569

RECORD

Cased in., ft.

Sand

Gas

Oil

Total Depth 4610

PRODUCTION

1st 24 hrs. Nat.

1st 24 hrs. after shot

Gas Cu. Ft.

Dry Hole

Abandoned

Date

NOV 22 1944 19

S. J. LEWIS Scout