



Section 34 Township 28 Range 33-W
Well No. #1 Watkins
Company Helmerich & Payne et al

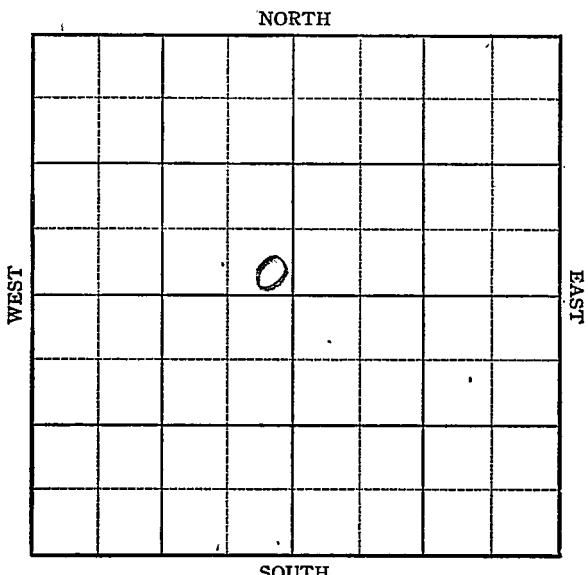

Sec. 34 Twp. 28 R. 33WWell No. #1 Watkins FarmHelmerich & Payne et al Company
Hugoton Ft. from N. Line150 Ft. from S. Line150 Ft. from E. Line Ft. from W. Line

SE NW

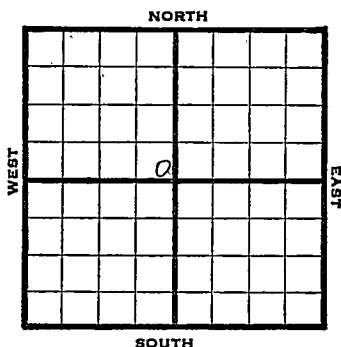

1946

2960

REPORT

	Location
7/3	"
7/9	"
7/16	"
7/23	"
7/30	"
8/6	"
8/13	"
8/20	"
8/27	"
9/5	"
9/10	10" @ 680'
	TD-2635,
	7" @ 2632 RUST
9/18	Drlg 2653'
9/24	TD 2745
	3000 acid
10/1	" "
10/8	" "
10/15	5000 acid
10/22	" "
10/29	" "
11/6	" "
11/12	" "
11/20	" "

OVER

1946

11/27 7" @ 2632'

TD 2745'

24,500 Acid

5,640,000 Gas

410# RPR

COMPLETED

KANSAS


Kansas Pool Name HugotonMap No. 1000 Sec. 34 Twp. 28 R. 33WWell No. 1 WatkinsHelmerich & Payne et al. Company

FIRST REPORT

Contractor

SE NW

SECTION PLAT

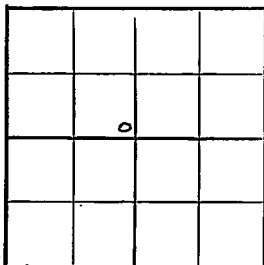

Ft. from N. Line

150

Ft. from S. Line

150

Ft. from E. Line

Ft. from W. Line

Haskell County

Location X

Rig up

Drilling and Remarks:

RECORD

Cased _____ in., _____ ft.

Sand _____

Gas _____

Oil _____

Total Depth _____

PRODUCTION

1st 24 hrs. Nat. _____

1st 24 hrs. after shot _____

Gas _____ Cu. Ft.

Dry Hole _____

Abandoned _____

Date

JUL 3 1946 19

S. J. LEWIS

Scout

no value

Misc. Small Maps	<i>[initials]</i>
Cards	<i>[initials]</i>
Tracing	<i>[initials]</i>
France Map	<i>[initials]</i>
Scarborough Map	<i>[initials]</i>
Pierce Map	<i>[initials]</i>
Geological Dept.	
Force Plat Book	

Map No. _____ Sec. 34 Twp. 28 R. 33W

Well No. 1 Watkins

Helmerich & Payne etal. Company

COMPLETED

Contractor

SE NW

21,2960

SECTION PLAT

_____ Ft. from N. Line

150 Ft. from S. Line

150 Ft. from E. Line

_____ Ft. from W. Line

Haskell County

Location _____

Rig up _____

Drilling and Remarks:

7" C 2 1/2"

245000000

5,640,000 Gas

410 # R/P

RECORD

Cased _____ in., _____ ft.

Sand _____

Gas _____

Oil _____

Total Depth 2745

PRODUCTION

1st 24 hrs. Nat. _____

1st 24 hrs. after shot _____

Gas _____ Cu. Ft.

Dry Hole _____

Abandoned _____

Date

NOV 27 1946

19

S. J. LEWIS

Scout

no wait msp

Misc. Small Maps	☒
Cards	☒
Tracing	☒
France Map	☒
Scarborough Map	☒
Pierce Map	☒
Ceological Dept.	☐
Pierce Plat. Book	☐