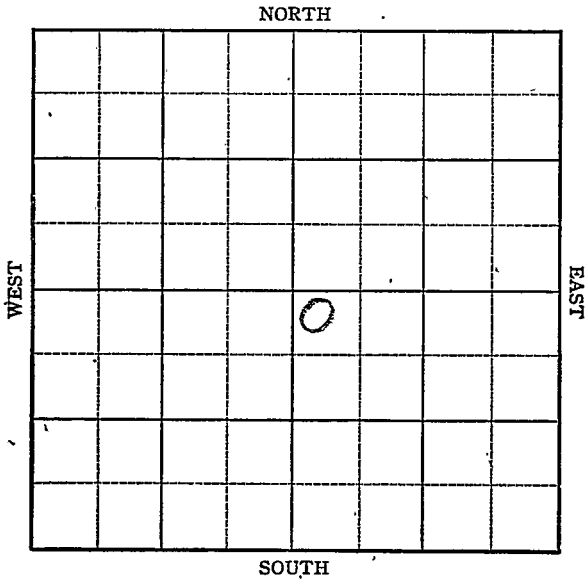


Section 34 Township 28 Range 34-WWell No. #1 ReimerCompany Helmerich & Payne et al

Sec. 34 **KANSAS** Twp. 28 R. 34W

Well No. #1 Riemer Farm

Helmerich & Payne et al Company


Hugoton

150 Ft. from N. Line

 Ft. from S. Line

 Ft. from E. Line

150 Ft. from W. Line

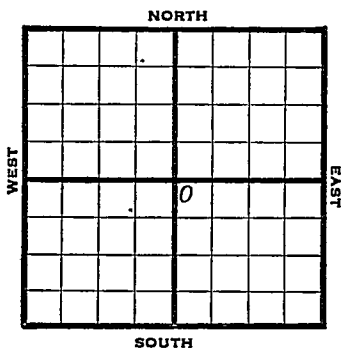

NW SE

1946 2996 REPORT

7/3	Location
7/9	"
7/16	"
7/23	"
7/30	"
8/6	"
8/13	"
8/20	8" @ 877 Drlg. 2103'
8/27	TD 2814 7" @ 2807 RUST
9/5	223 shots 2590-2780'
9/10	13000 acid
9/18	" "
9/24	12000 acid
10/1	" "
10/8	" "
10/15	" "
10/22	" "
10/29	" "
11/6	" "
11/12	" "
11/20	" "

OVER

1946

" ,

11/27 7" @ 2807'
Perf
29,000 Acid
TD 2814'
539,000 Gas
420~~11~~ RPR

COMPLETED

KANSAS

Kansas Pool Name HugotonMap No. map Sec. 34 Twp. 28 R. 34WWell No. 1 RiemerHelmerich & Payne etal. Company

FIRST REPORT

Contractor

NW SE

SECTION PLAT

		o	

150 Ft. from N. Line Ft. from S. Line Ft. from E. Line150 Ft. from W. LineHaskell CountyLocation XRig up

Drilling and Remarks:

RECORD

Cased in., ft.Sand Gas Oil Total Depth

PRODUCTION

1st 24 hrs. Nat. 1st 24 hrs. after shot Gas Cu. Ft.Dry Hole Abandoned

Date

JUL 3 1946 19S. J. LEWIS

Scout

Misc. Small Maps

Cards

Tracing

France Map

Scarborough Map

Pierce Map

Geological Dept.

France Plat Book

Map No. _____ Sec. 34 Twp. 28 R. 34W

Well No. 1 Riemer

Helmerich & Payne etal. Company

COMPLETED

Contractor

NW SE

E12986


SECTION PLAT

150 Ft. from N. Line

_____ Ft. from S. Line

_____ Ft. from E. Line

150 Ft. from W. Line

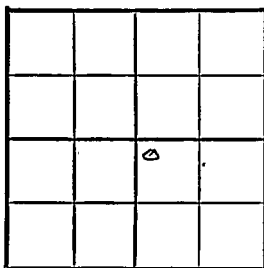

Haskell County

Location _____

Rig up _____

Drilling and Remarks:

7" C 2807

Ref

29000 Acid

589,000 Gall

420 # R Pz

RECORD

Cased _____ in., _____ ft.

Sand _____

Gas _____

Oil _____

Total Depth 2874

PRODUCTION

1st 24 hrs. Nat. _____

1st 24 hrs. after shot _____

Gas _____ Cu. Ft.

Dry Hole _____

Abandoned _____

Date

NOV 27 1946

19

S. J. LEWIS

Scout

no wall map

Misc. Small Maps	✓
Cards	<u>Sarah</u>
Tracing	<u>✓</u>
France Map	✓
Scarborough Map	✓
Pierce Map	<u>✓</u>
Geological Dept.	
Pierce Plat Book	