

SECTION 35 TOWNSHIP 28S RANGE 2W

WELL NO. #1 Struthers


COMPANY Bennett & Hilbert *Cherry Arlg.*

NORTH

*SE/SE NW*

WEST

EAST

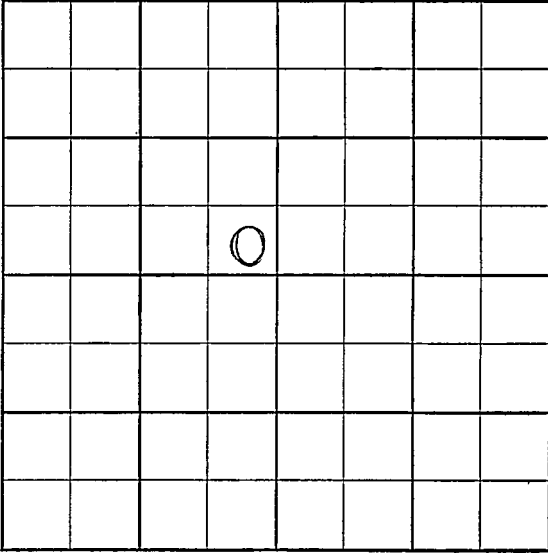

SOUTH



K 28

CORRELATION

S-513-A

CO. ~~Wichita~~ ELEV 1360

SEC. 3 TWP. 18 RGE. 21

COMPANY ~~Sennett &~~ NO. 1

ABANDONED  
NOV 27 '57

Cherry Pt 9

FARM Struthers

LOC. S 37 W


GEOL. \_\_\_\_\_

CONTR. Co. 11th Dist.

POOL \_\_\_\_\_

SPUD 11-15-57

8" 197/200 42615  
L 2993

M 3616 DST

3618-40 60"

PB 330' SW

BHP 1315/20" RTD 3640  
one log

D & A

USE  
NO.  
SEC.  
TWP.  
RGE.