

KANSAS


Haskell county

FORM 51 5M 6-46 PETROL

Section 35 Township 28 Range 34-W

Well No. #1 McCoy

Company Helmerich & Payne

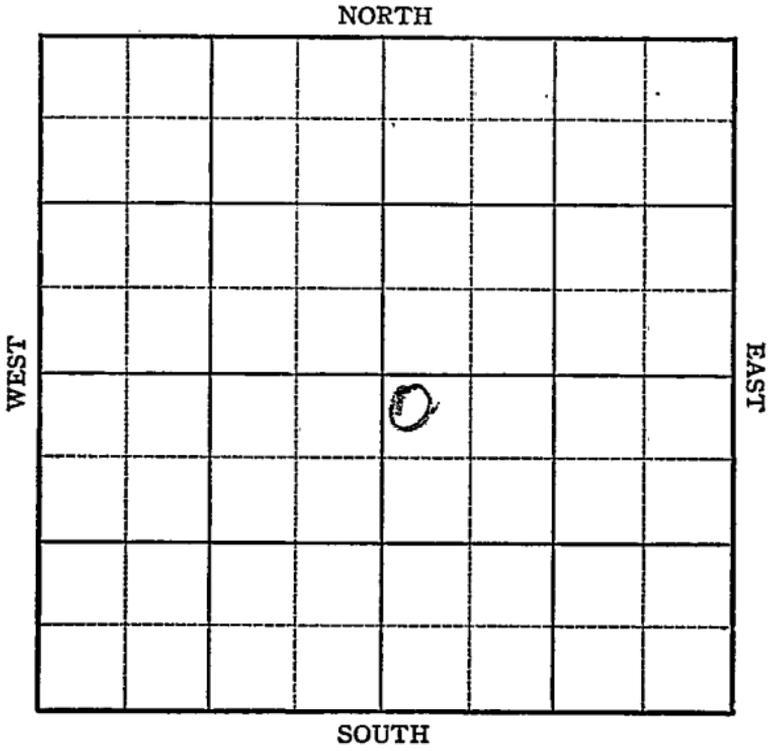

Sec. 35 Twp. 28 R. 34W

Well No. #1 McCoy Farm

Helmerich & Payne Company


Hugoton

150 Ft. from N. Line

_____ Ft. from S. Line

_____ Ft. from E. Line

150 Ft. from W. Line

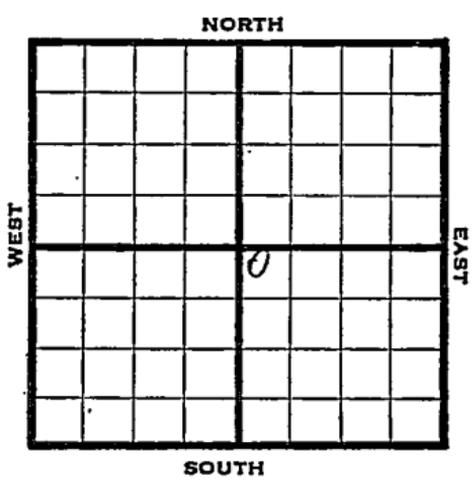

NW SE

1946 2983 REPORT

7/3	Location
7/9	"
7/16	"
7/23	"
7/30	"
8/6	"
8/13	"
8/20	"
8/27	RUR
9/5	Drlg 2600'
9/10	10" @ 617 TD 2814'
	7" @ 2815 RUST
9/18	198 shots 2588-2780, 3000 acid
9/24	5000 acid
10/1	" "
10/8	" "
10/15	8000 acid
10/22	" "
10/29	" "
11/6	" "
11/12	" "
11/20	" "

OVER

1946

11/27 7" @ 2805'
Perf
29,000 Acid
470,000 Gas
TD 2814'
420# RPR

COMPLETED

KANSAS Kansas Pool Name Hugoton

Map No. 1111 Sec. 35 Twp. 28 R. 34W

Well No. 1 Mc Coy

Helmerich & Payne Company

FIRST REPORT Contractor

NW SE

SECTION PLAT

150 Ft. from N. Line

_____ Ft. from S. Line

_____ Ft. from E. Line

150 Ft. from W. Line

		o	

Haskell County

Location X

Rig up _____

Drilling and Remarks:

RECORD

Cased _____ in., _____ ft.

Sand _____

Gas _____

Oil _____

Total Depth _____

PRODUCTION

1st 24-hrs. Nat. _____

1st 24 hrs. after shot _____

Gas _____ Cu. Ft.

Dry Hole _____

Abandoned _____

Date

JUL 3 1946 19

S. J. LEWIS Scout

no well

Small Maps	<i>[initials]</i>
<i>Perry</i>	
ing	<i>[initials]</i>
ance Map	<i>[initials]</i>
Scarborough Map	<i>[initials]</i>
Pierce Map	<i>[initials]</i>
Geological Dept.	
Pierce Plat Book	

Map No. _____ Sec. 35 Twp. 28 R. 34W

Well No. 1 McCoy

Helmerich & Payne Company

COMPLETED

Contractor

NW SE

E. 2988

SECTION PLAT

150 Ft. from N. Line

_____ Ft. from S. Line

_____ Ft. from E. Line

150 Ft. from W. Line

		0	

Haskell County

Location _____

Rig up _____

Drilling and Remarks:

7' casing

Perf.

29000 acid

470,000 Gas

420 # R/P

RECORD

Cased _____ in., _____ ft.

Sand _____

Gas _____

Oil _____

Total Depth 2814

PRODUCTION

1st 24 hrs. Nat. _____

1st 24 hrs. after shot _____

Gas _____ Cu. Ft.

Dry Hole _____

Abandoned _____

Date

NOV 27 1946 19

S. J. LEWIS

Scout

no wall map

AM

Misc. Small Maps	<input checked="" type="checkbox"/>
Cards	<i>French</i>
Tracing	<input checked="" type="checkbox"/>
France Map	<input checked="" type="checkbox"/>
Scarborough Map	<input checked="" type="checkbox"/>
Pierce Map	<input checked="" type="checkbox"/>
Geological Dept.	<input type="checkbox"/>
Pierce Flat Book	<input type="checkbox"/>