

Kingman

KANSAS


DX 78-1

Section 35 Township 28S Range 8W

Well No. #1 Engelbert Biggs.

Company Ute Royalty Corp. (F.K. Johnson,
Longview, Texas)

NORTH

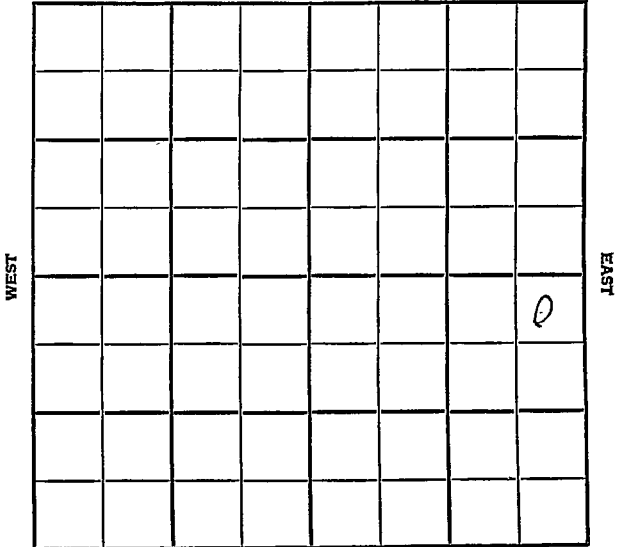

SOUTH

KARISAO

WELL NO.

FARM

COMPANY

CONTRACTOR

Longview, Texas)

Bennett & Roberts

Wildcat.

NORTH

330

Ft. from N. Line


Ft. from S. Line

330

Ft. from E. Line

Ft. from W. Line

NE NE SE

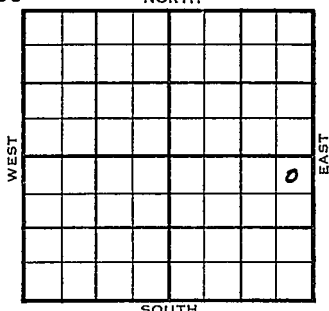

1954

ELEVATION

1608'

REPORT

12/8

Spud 12-5-54

8th @ 125' w/100 sks.

WOC.

12/29

Spud 12-5-54 D & A TD 4473

8" @ 125' Tonganoxie 3240'

DST 3231-71 open 1 hr rec 1400' SW

1200# Br. lime 3321' Lans 3340

DST 3341-69 open 1 hr rec 150' gas,
60' SOCM, 40' wtry mud, 450#

Miss 4066

DST 4066-80 open 1 hr gas in 5 min

25,000 CFG, rec 85' GCM 11420#

DST 4080-4100 open 1 hr gas in 44 min

25,000 CFB, 210' GCM, 180' MSW 1370#

Kh. 4294¹ Viola 4427²


DST 4418-40, open 1 hr rec 15' mud 0#

Simp. 4452' TD 4473'

D & A

ABANDONED

County Kingman State Kansas
 Sec. 35 (Bk.) 28 (Sur.) 8W Map No.
 Operator Ute Royalty Corp.
 Well No. 1 Farm Engelbert-Biggs
 Elev. 1608 Location NE NE SE

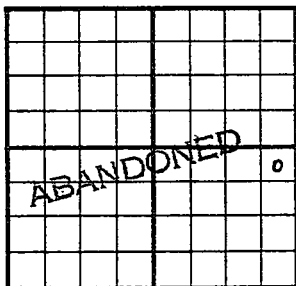

330 Ft. From N Line SE
330 Ft. From E Line Quarter
 Ist. Report
 Completion DEC 29 1954
 Remarks Wildcat
B & R - Contr.
 Spudding Date 12-5-54

Drlg. Data D & A TD 4473
8" @ 125 Tonganoxie 3240 DST 3231-71
open 1 hr. Rec. 1400' sw 1200#
Br. lime 3321 Lans. 3340 DST 3341-69
open 1 hr. Rec. 150' gas 60' socm
40'wtry mud 450# Miss. 4066
DST 4066-80 open 1 hr. gas in 5 min.
25,000 cfg Rec. 85' gcm 1420#
DST 4080-4100 open 1 hr. gas in 44 min.
25,000 cfg 210' gcm 180' msw 1370#
Kh. 4294 Viola 4427 DST 4418-40
open 1 hr. Rec. 15' mud 0#
Simp. 4452 TD 4473

D & A

FABEN GILSTRAP