

Sedgwick


KANSAS

SECTION 36 TOWNSHIP 28 RANGE 1 W

WELL NO. #13 Wright

COMPANY E. H. Adair

NORTH

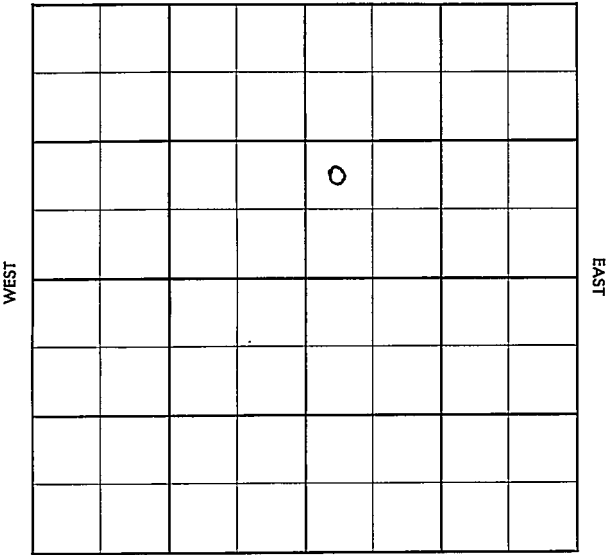

SOUTH

Sedgwick

KANSAS

SEC.	TWP.	R.
36	28	1W

WELL NO.

#13 Wright

FARM

COMPANY

E. H. Adair

CONTRACTOR

Co. Tools

Gladys


\_\_\_\_\_ Ft. from N. Line

\_\_\_\_\_ Ft. from S. Line

\_\_\_\_\_ Ft. from E. Line

\_\_\_\_\_ Ft. from W. Line

NW SW NE

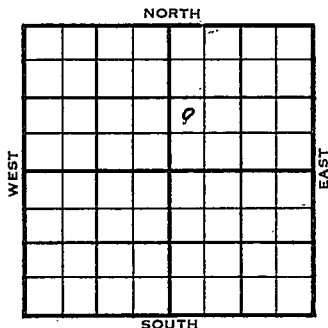

	ELEVATION	REPORT
1955	1289'	
11/16	Comm 11-13-55 8" :@ 170/125 Drlg 230	
12-21	5 1/2" @ 3204/100 CO DD 3216 2000 A S/ 20 boph Comp. 266 bopd KC. 2678 BKC 2876 Chert 3186 Li 3188 M. Dolo 3208 TD 3213'	

COMPLETED



County Sedgwick Elev. 1289  
 Sec. 36 Twp. 28 Rge. IW  
 Company E. H. Adair  
 FarmName Wright No. 13

TOPS	DEPTH	LOG	DATUM
Anh.			
Tp.			
H.			
Tr.			
Dg.			
Bl.			
L.			
K.C.	<u>2628</u>		<u>1389</u>
B.K.C.	<u>2876</u>		<u>1587</u>
Ce.			
C.			
M. <u>Chert</u>	<u>3186</u>		<u>1897</u>
M. <u>Li</u>	<u>3188</u>		<u>1899</u>
M. <u>Dolo</u>	<u>3208</u>		<u>1919</u>
Mz.			
Mq.			
V.			
S.			
S.			
A.			
R.			
Pe.			
G.			
T.D.	<u>3213</u>		

Loc. in Sec. NW SW NE  
 Geol. \_\_\_\_\_  
 Contr. \_\_\_\_\_  
 Co. tools \_\_\_\_\_  
 Pool \_\_\_\_\_  
 Gladys \_\_\_\_\_

	6	

COMPLETE

Date Comm. 11-13-55 DEC 21 1955  
8" @ 170/125 5 1/2" @ 3204/100 CO  
DD 3216 2000 A S/ 20 boph  
 Comp. 266 bopd

Co. Sec. T. R.