


Sedgwick

KANSAS

SECTION 36 TOWNSHIP 28 RANGE 1 WWELL NO. #1 RodgersCOMPANY Shawver-Armour

NORTH

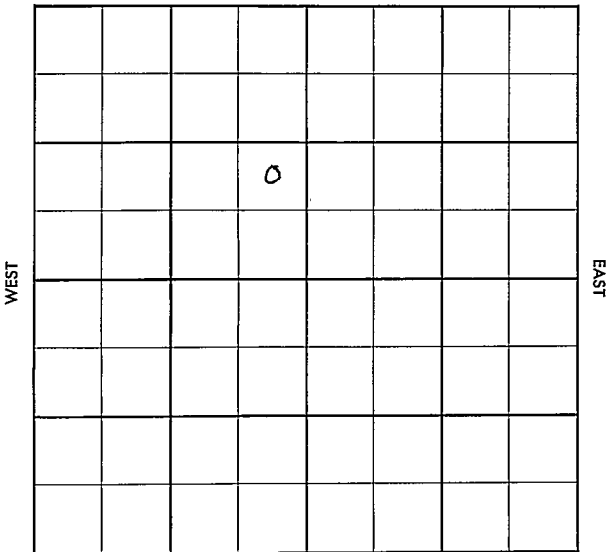

SOUTH

Sedgwick

KANSAS

SEC.	TWP.	R.
36	28	1W

WELL NO.

#1 Rodgers

FARM

COMPANY

Shawver-Armour

CONTRACTOR

Co. tools


Gladys

Ft. from N. Line

Ft. from S. Line

Ft. from E. Line

Ft. from W. Line

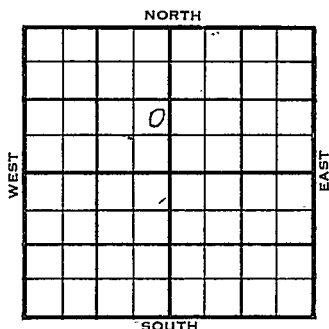

NE SE NW

	ELEVATION	REPORT
1956	1291'	

2-1

RUE

3-14

Comm. 1-31-56
 8 5/8" @ 194/175
 5 1/2" @ 3218/10
 DD 3224, 2000 A
 S/ 6 boph
 Comp. 133 bopd
 L. 2694
 C. 3204
 M. lm 3212
 M. dolo 3219
 TD 3222

COMPLETED

County Sedgwick Elev. _____
 Sec. 36 Twp. 28 Rge. 1W
 Company Shawver-Armour
 Farm Name Rodgers No. 1

Co.

Lse.

No.

Sec.

T.

R.

TOPS	DEPTH	LOG	DATUM
Anh.			
Tr.			
H.			
Tr.			
Dg.			
BL.			
L.			
K.C.			
B.K.C.			
Ce.			
C.			
M.			
M.			
K.			
Mz.			
Me.			
V.			
S.			
S.			
A			
R.			
PE.			
G.			
T.D.			

Loc. in Sec. _____

NE SE NW

Geol. _____

Contr. _____

Co. tools

Pool

Gladys

FEB 9 '56		
0		
FIRST REPORT		

Date Comm.

R U R

County Sedgwick Elev. 1291
 Sec. 36 Twp. 28 Rge. 1W
 Company Shaeffer - Armour
 Farm Name Rodgers No. 1

TOPS	DEPTH	LOG	DATUM	Loc. in Sec.
Anh.				NE SE NW
Tr.				
Dg.				
Bl.				
L.	<u>2694</u>		<u>1403</u>	Geol.
K.C.				Contr.
B.K.C.				Co. tools
Ce.				Pool
C.	<u>3204</u>		<u>1913</u>	Gladys
M.	<u>3212</u>		<u>1921</u>	COMPLETE
M.	<u>3219</u>		<u>1928</u>	
K.				
Mz.				
Me.				
V.				
S.				
S.				
A.				
R.				
PE.				
G.				
T.D.	<u>3222</u>			

Date Comm. 1-31-56 MAR 1 4 1956

8 5/8" @ 194/175 5 1/2" @ 3218/10

DD 3224 2000 A S/ 6 boph

Comp. 133 bopd