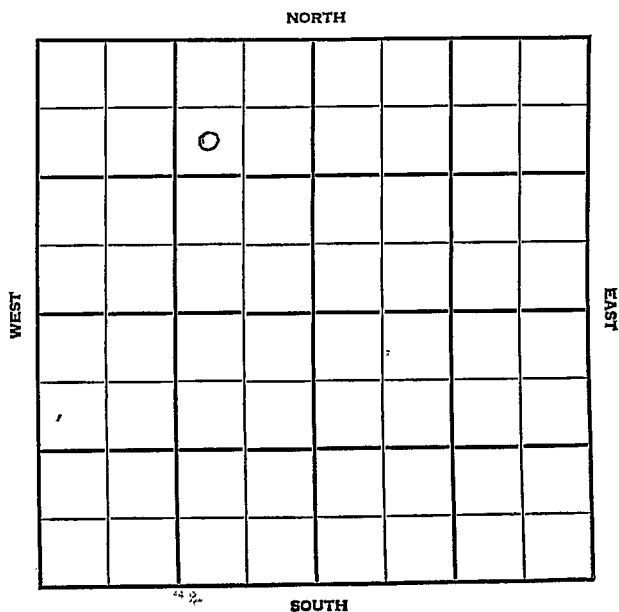


Section 36 Township 28 Range 1 WWell No. #3 HayCompany Shawver-Armour

Sedgwick

KANSAS

|            |            |          |
|------------|------------|----------|
| SEC.<br>36 | TWP.<br>28 | R.<br>1W |
|------------|------------|----------|

WELL NO.

#3 Hay

FARM

COMPANY

Shawver-Armour

CONTRACTOR

Gladys


Ft. from N. Line

Ft. from S. Line

Ft. from E. Line

Ft. from W. Line

SW NE NW

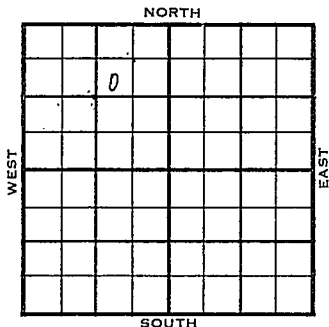

1956

ELEVATION

1298'

REPORT

2-8

Loc.

County Sedgwick Elev. 1298  
 Sec. 36 Twp. 28 Rge. 1W  
 Company Sharver-Armour  
 Farm Name Hay No. 3

| TOPS   | DEPTH | LOG | DATUM | Loc. in Sec. |
|--------|-------|-----|-------|--------------|
| Anh.   |       |     |       | SE NE NW     |
| TP.    |       |     |       |              |
| H.     |       |     |       |              |
| Tr.    |       |     |       |              |
| Dg.    |       |     |       |              |
| Bl.    |       |     |       |              |
| L.     |       |     |       | Geol.        |
| K.C.   |       |     |       | Contr.       |
| B.K.C. |       |     |       |              |
| Ce.    |       |     |       |              |
| C.     |       |     |       |              |
| M.     |       |     |       | Pool         |
| M.     |       |     |       | Gladys       |
| K.     |       |     |       |              |
| Mz.    |       |     |       |              |
| Mq.    |       |     |       |              |
| V.     |       |     |       |              |
| S.     |       |     |       |              |
| S.     |       |     |       |              |
| A.     |       |     |       |              |
| R.     |       |     |       |              |
| PE.    |       |     |       | FIRST REPORT |
| G.     |       |     |       |              |
| T.D.   |       |     |       | FEB 8 '66    |

Date Comm.

Location