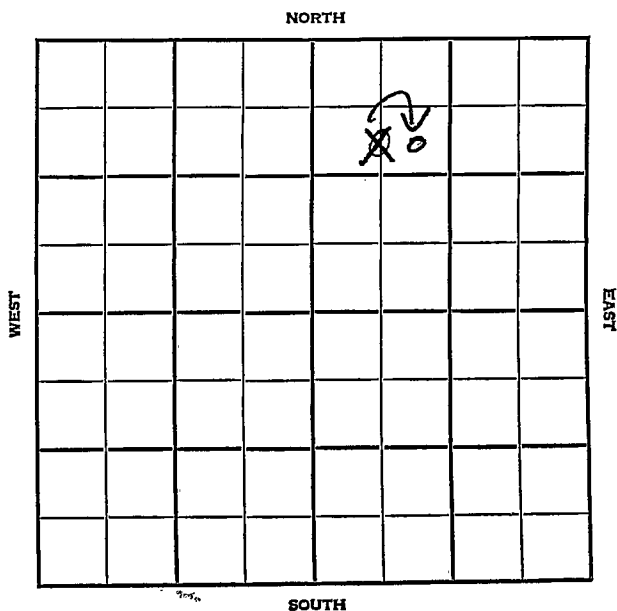


DX 78-1

Section 36 Township 28 Range 1 WWell No. # 8 WrightCompany E. H. Adair

Sedgwick

KANSAS

SEC. 36	TWP. 28	R. 1W
------------	------------	----------

WELL NO.

#8 Wright

FARM

COMPANY

E. H. Adair

CONTRACTOR

Co. Tools


Gladys

990 Ft. from N. Line

Ft. from S. Line

1500 Ft. from E. Line

Ft. from W. Line

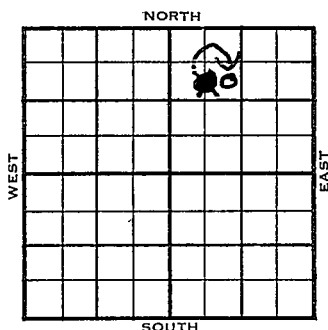~~C-S~~¹/₂ NW NE
SE


	ELEVATION	REPORT
1955%	1282	

8/3 Comm. 7-31-55
8" @171/135 **FIRST REPORT**

9/28 Comm 7-31-55
8" @ 171/135
5 1/2" @ 3205
H 2073
L 2312
KC Stal 2340
BKC KC 2666
Ce BKC 2850
C 3174
M 3181
M Dolo 3205
TD 3208
DD 3211 2000 A F/20 bopd

COMPLETED

२.

SCOUT TICKET

DX-201

Kausch

SEC.

36

TWP.

28

R.

1W

WELL NO.

8 Wright

FARM

COMPANY

E. H. Adair

CONTRACTOR

CORRECTION


SE NW NE

990 FT. FROM N. LINE

FT. FROM S. LINE

1500 FT. FORM E. LINE

FT. FROM W. LINE

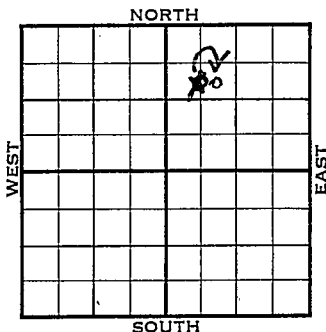

Sedgwick County

☐

LOCATION

☐

RIG UP

DRILLING AND REMARKS:

Reported
CS $\frac{1}{2}$ NW NE

RECORD

CASED IN., FT.

SAND

GAS

OIL

TOTAL DEPTH

1ST 24 HRS. NAT.

1ST 24 HRS. AFTER SHOT

GAS CU. FT.

DRY HOLE

ABANDONED

PRODUCTION

DATE

AUG 10 1955

SCOUT

L. J. Harris

County Sedgwick Elev. 1282
 Sec. 36 Twp. 28 Rge. 1W
 Company E. H. Adair
 Farm Name Wright No. 8

TOPS	DEPTH	LOG	DATUM	Loc. in Sec.
Anh.				SE NW NE
Tr.				1500' EL
H.	<u>2073</u>		<u>791</u>	
Tr.				
Dg.				
BL.				
L.	<u>2312</u>		<u>1030</u>	Geol.
K.C. <u>Stal</u>	<u>2340</u>		<u>1058</u>	Contr.
B.K.C. <u>KC</u>	<u>2666</u>		<u>1384</u>	Co. tools
Ce. <u>BKC</u>	<u>2850</u>		<u>1568</u>	Pool
C.	<u>3174</u>		<u>1892</u>	Gladys
M.	<u>3184</u>		<u>1899</u>	
M. <u>Dnln</u>	<u>3205</u>		<u>1923</u>	
K.				
Mz.				
Ma.				
V.				
S.				
S.				
A.				
R.				
Pe.				
G.				
TD.	<u>3208</u>			COMPLETE

Date Comm. 7-31-55 SEP 28 1955
8" @ 171/135 5 1/2" @ 3205 DD 3211
2000 A F/ 20 boph Comp. F/ 326 bopd