

Grant

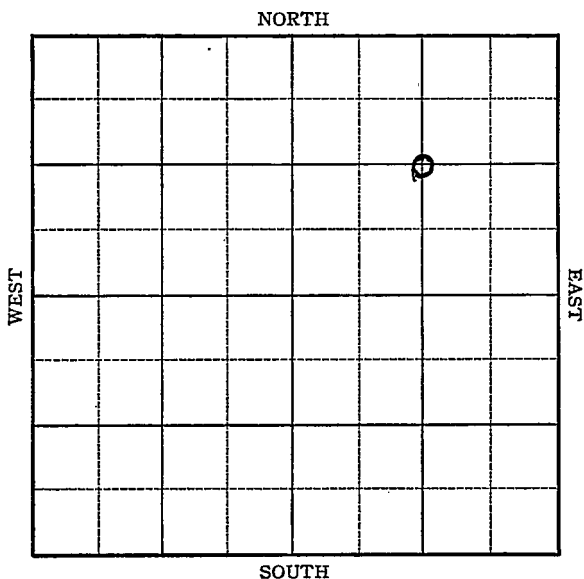
Form 51-5M 5-37 Petrol

KANSAS

Section 36 Township 28 Range 37-~~W~~

Well No. #1 C.A. Smith

Company ~~Parrish~~ R. K. Wilson

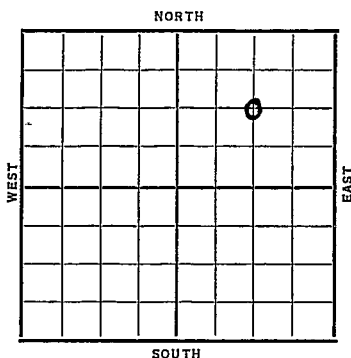


Sec. 36 Twp. 28 R. 37WWell No. 1-C.A. Smith Farm~~Barrieh~~ R.K. Wilson Company1320 Ft. from N. Line

_____ Ft. from S. Line

1320 Ft. from E. Line

_____ Ft. from W. Line

Elev. 3057
~~3050~~

Date	REPORT
1937	
8/11	Location
8/20	"
9/3	"
9/10	"
9/17	R U R
9/24	"
10/2	"
10/8	"
10/15	Shut down.
10/22	" "
10/29	" "
11/5	R U R
11/12	10" @ 552'. Drlg. 1300'.
11/19	7" @ 2337' T.D. RUST.
11/26	7" @ 2395'. (Corrected)
12/3	Fsg. 2425'.
12/10	Drlg. 2560'.
	OVER

1937

12/15 7" @ 2395'.

Sand ?

T.D. 2720'.

6 M gas.

COMPLETED

Grant **KANSAS**Map No. _____ Sec. *36* Twp. *28* R. *37*^WWell No. *1-C. A. Smith**R. K. Wilson* Company

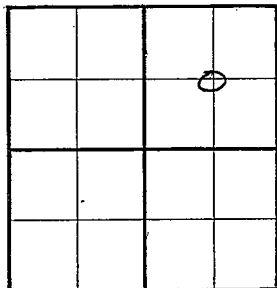
Contractor

CORRECTION*1320* Ft. from N. Line

_____ Ft. from S. Line

1320 Ft. from E. Line

_____ Ft. from W. Line

SECTION PLATLocation ☒

Rig up _____

Drilling and Remarks:

*first reported
as being drilled
by Patrick*

RECORD

Cased _____ in., _____ ft.

Sand _____

Gas _____

Oil _____

Total Depth _____

PRODUCTION

1st 24 hrs. Nat. _____

1st 24 hrs. after shot _____

Gas _____ Cu. Ft.

Dry Hole _____

Abandoned _____

Date

AUG 25 1937**H. D. Hatfield**

Scout

Returned

Cards

Tracing

France Map

Scarborough Map

Moody Map

Scarborough Plat Book

Moody Plat Book

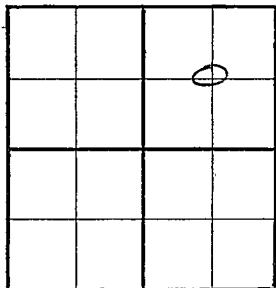
KANSAS Grant

Map No. NM Sec. 36 Twp. 28 R. 37WWell No. 1-C. A. Smith
Parrish Company

Contractor

FIRST REPORT

SECTION PLAT

1320 Ft. from N. Line

_____ Ft. from S. Line

1320 Ft. from E. Line

_____ Ft. from W. Line

Location ✓

Rig up _____

Drilling and Remarks:

RECORD

Cased _____ in., _____ ft.

Sand _____

Gas _____

Oil _____

Total Depth _____

PRODUCTION

1st 24 hrs. Nat. _____

1st 24 hrs. after shot _____

Gas _____ Cu. Ft.

Dry Hole _____

Abandoned _____

Date

AUG 11 1937H. D. Hatfield Scout

no more

Ray

Returned	<i>Paul</i>
Cards	
Tracing	
France Map	☒
Scarborough Map	☒
Moody Map	
Scarborough Plat Book	
Moody Plat Book	

Grant

KANSAS

Map No. N M Sec. 36 Twp. 28 R. 37WWell No. 1 C. A. SmithR. K. Wilson

Company

Contractor

COMPLETED

SECTION PLAT

C NE

1320 Ft. from N. Line

____ Ft. from S. Line

1320 Ft. from E. Line

____ Ft. from W. Line

Location _____

Rig up _____

Drilling and Remarks:

6 M gas

RECORD

Cased 7 in., 2395 ft.

Sand _____

Gas _____

Oil _____

Total Depth 2720

PRODUCTION

1st 24 hrs. Nat. _____

1st 24 hrs. after shot _____

Gas _____ Cu. Ft.

Dry Hole _____

Abandoned _____

Date

DEC 15 1937

19

H. D. Hatfield Scout

33

1

7

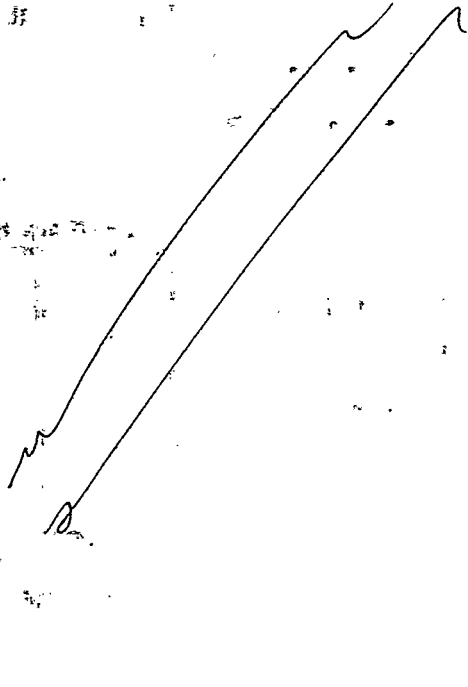
44
115

Handy






Returned	
Cards	<i>[Signature]</i>
Tracing	
Frame Map	✓
Outline Map	X
Muddy Map	
Seals	Outlook
Seals	ok