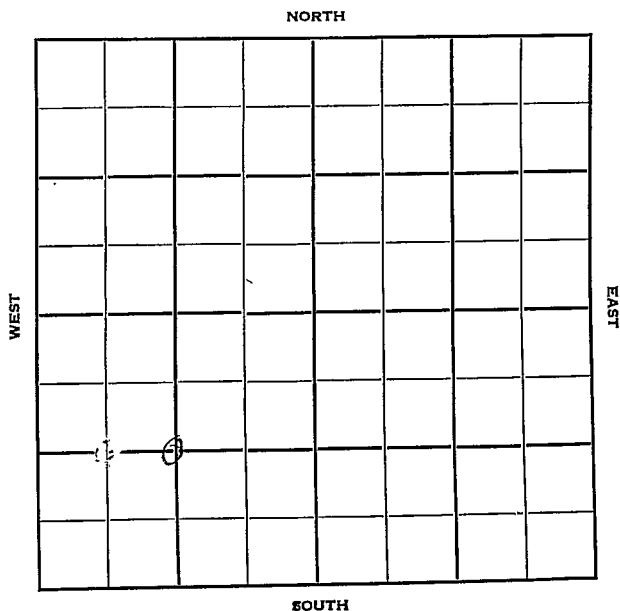


Section 36 Township 28 Range 37WWell No. #1 H. W. StubbsCompany Columbian Fuel

Grant

KANSAS

Sec. 36 Twp. 28 R. 37W ✓

Well No. #1 H. W.- Stubbs Farm

Columbian Fuel Company

Hugoton Pool Contractor


 Ft. from N. Line

1320' Ft. from S. Line

 Ft. from E. Line

1320' Ft. from W. Line

C SW

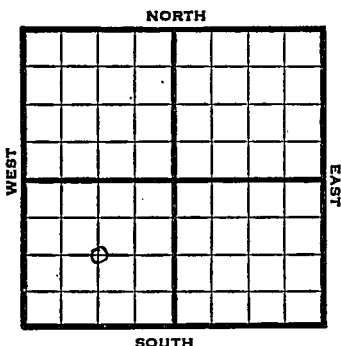

1950

Elev 2996

REPORT

3/29

Location

5/31

10" @ 60

7" @ 2409

Hev 2410

Krider 2439

Win 2478

Ft. Riley 2532

comp 12,652,000 gas

COMPLETED

Map No. _____ Sec. 36 Twp. 28 R. 37WWell No. 1 H. W. Stubbs

_____ Columbian Fuel _____ Company

_____ Contractor

C SW

SECTION PLAT



_____ Ft. from N. Line

1320 Ft. from S. Line

_____ Ft. from E. Line

1320 Ft. from W. LineGrant CountyLocation X

Rig up _____

Drilling and Remarks:

RECORD

Cased _____ in., _____ ft.

Sand _____

Gas _____

Oil _____

Total Depth _____

PRODUCTION

1st 24 hrs. Nat. _____

1st 24 hrs. after shot _____

Gas _____ Cu. Ft.

Dry Hole _____

Abandoned _____

Date


MAR 29 195019J. E. TYRAScout

Map No. _____ Sec. 36 Twp. 28 R. 37WWell No. 1 H. W. StubbsColumbian Fuel Company

C ST _____ Contractor

El. 2996

SECTION PLAT

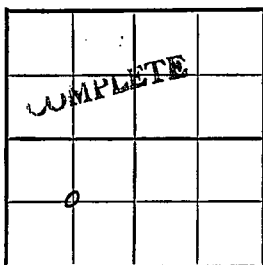

_____ Ft. from N. Line

1320 Ft. from S. Line

_____ Ft. from E. Line

1320 Ft. from W. Line

Grant

Location _____

Rig up _____

Drilling and Remarks:

10" @ 607" @ 2409T.D. 2620Rev. 2410Krider 2439Win. 2478Fr. Riley 2532Comp. 112,652,000 gas

Date

RECORD

Cased _____ in., _____ ft.

Sand _____

Gas _____

Oil _____

Total Depth 2620

PRODUCTION

1st 24 hrs. Nat. _____

1st 24 hrs. after shot _____

Gas _____ Cu. Ft.

Dry Hole _____

Abandoned _____

MAY 31 1950

19

J. E. TYRA

Scout