


PRATT

KANSAS

SECTION 36 TOWNSHIP 28 RANGE 14 WWELL NO. #1 Pratt "A"COMPANY Phillips Pet.

NORTH

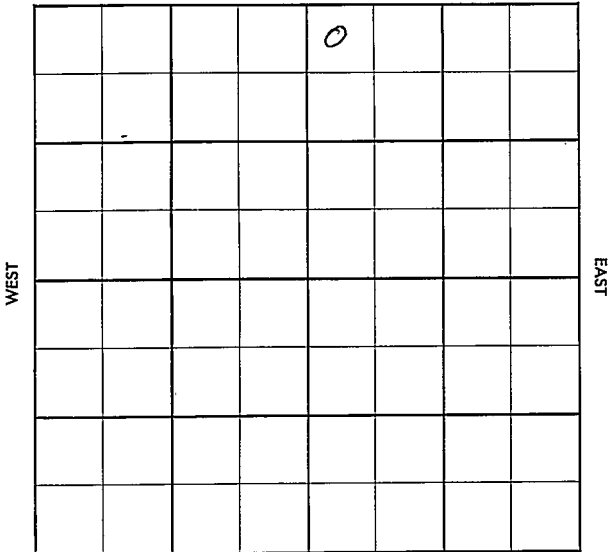

SOUTH

Pratt

KANSAS

SEC.	TWP.	R.
36	28	14W

WELL NO.

#1 Pratt "A"

FARM

COMPANY

Phillips Pet

CONTRACTOR

Co Tools

N. Earl

Ft. from N. Line


Ft. from S. Line

Ft. from E. Line

Ft. from W. Line

325'

NW NW NE

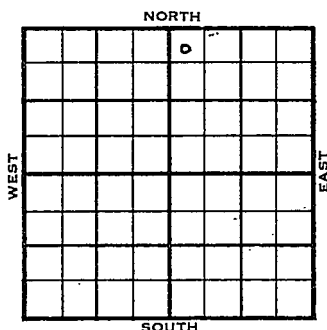

	ELEVATION	REPORT
1955	1986'	
11/16	Comm 11-13-55 9" @ 363/250 Drlg 1414	
12-21	7" @ 4565 CO, 40/ 4499-4509 B/ 2 $\frac{1}{4}$ gw, 3 hrs, 500 A, S/ 1 bo, 18 bw, 5 hrs. PB 4175, 12/ 4121-24 B/ 6 gw, 4 hrs., 500 A S/ 47 bw 7 hrs. PB 4045, 12/ 3285-88 B/ 2 2 $\frac{1}{2}$ gw 3 hrs., 500 A S/ 1.17 BWPH D & A	
	<u>TOPS</u>	<u>DEPTH</u> <u>LOG</u>
	H.	3753 3756
	Tr.	3773 3774
	Dg.	3794
	Bl.	3937 3940
	L.	3960 3961
	Drum	4118 4120
	BKC	4317 4320
	Marm	4333 4334
	M.	4419 4421 -- Pre cb. 4595-4596
	V.	4454 4457
	Sh.	4487 4492 TD 4596'
	Sd.	4500- 4490

DX-78

ABANDONED

County Pratt

Elev. _____

Sec. 36

Twp. _____

Rge. 28Rge. 14W

Company _____

Phillips Pet.

Farm Name _____

Pratt #A10No. 1

TOPS

DEPTH

LOG

DATUM

Loc. in Sec. _____

Anh. _____

Tp. _____

H. _____

Tr. _____

Dg. _____

BL. _____

L. _____

K.C. _____

B.K.C. _____

Ce. _____

C. _____

M. _____

M. _____

K. _____

Mz. _____

Mo. _____

V. _____

S. _____

S. _____

A. _____

R. _____

P.C. _____

G. _____

T.D. _____

NW NW NE

325' WL


Geol. _____

Contr. _____

Co. tools

Pool _____

N. Earl

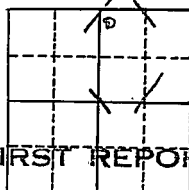

FIRST REPORT

NOV 16 1955

Date Comm. 11-13-55

9m @ 363/250 drlg. 11/11

25
LG

County Pratt Elev. 1986
 Sec. 36 Twp. 28 Rge. 14W
 Company Phillips Pet.
 Farm Name Pratt "A" No. 1

TOPS	DEPTH	LOG	DATUM	Loc. in Sec.
Anh. /				NW NW NE
Tp.				325' WL
H.	3753	3756	1770	
Tr.	3773	3774	1788	
Dg.	3794		1808	
Bl.	3937	3940	1954	
L.	3960	3961	1975	
K.C. <u>Drum</u>	4118	4120	2134	Geol.
B.K.C.	4317	4320	2334	Contr.
Ce. <u>Marm</u>	4333	4334	2348	Co. tools
C.				
M.	4419	4421	2435	Pool
M.				N. Earl
K.				
Mz.				
Mq.				
V.	4454	4457	2471	
S. <u>Sh</u>	4487	4492	2506	
S. <u>sd</u>	4500	4499	2513	
A	4583	4587	2601	
R. <u>Pre cb</u>	4595	4596	2610	ABANDONED
PE.				
G.				
T.D.	4596			

Date Comm. 11-13-55 DEC 21 1955

9" @ 363/250 7" @ 4565 CO 40/ 4499-

4509 B/ 2 $\frac{1}{4}$ gw 3 hr. 500 A S/ 1 bo

18 bw 5 hr. PB 4175 12/ 4121-24

B/ 6 gw 4 hr. 500 A S/ 47 bw 7 hr.

PB 4045 12/ 3985-88 B/ 2 $\frac{1}{2}$ gw 3 hr.

500 A S/ 1.17 bwph

D & A.