

Section 36 Township 28 Range 7 WWell No. # 1 ChristopherCompany M. B. Armer

NORTH

WEST

EAST

0							

SOUTH

Kingman, KANSAS

SEC.	TWP.	R.
36	1 28	7W ✓

WELL NO.

1 Christopher

FARM

COMPANY

M. B. Armer

CONTRACTOR

Lohman & Johnson


Wildcat

Ft. from N. Line

330 Ft. from S. Line

Ft. from E. Line

330 Ft. from W. Line

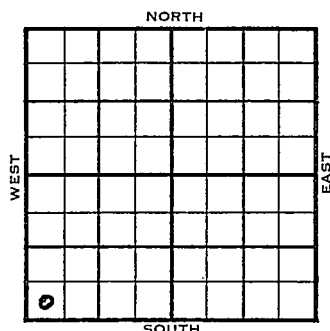

SW SW SW

1953

ELEVATION

1555'

REPORT

12/2

Spud 11-29-53
8" @ 254', WOC

12/9


Drlg. 3594'

12/16

Spud 11-29-53
D & A
TD 4465'
8" @ 254'
Br. Lime 3246' Lans 3256', Miss 4016'
DST 4018'-25' opn 45 min, gas in 30
min, rec 45' wtr cut mud 1075#
Simp 4428'
TD 4465'
D & A

ABANDONED

County Kingman State KansasSec. 36 (Blk. 28 (Sur. 7W (Twp. Map No.Operator M. B. ArmerWell No. 1 Farm ChristopherElev. Location SW SW SW330 Ft. From S Line SW330 Ft. From W Line Quarter1st. Report DEC 2 1953CompletionRemarksLohman & Johnson - Contr.Spudding Date 11-29-53Drlg. Data Wildcat8" @ 254 WOC.

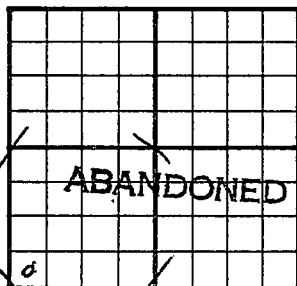County Kingman State KansasSec. 36 (Blk.
Twp.) 28 (Sur.
Rge.) 7W Map No.Operator M. B. ArmerWell No. 1 Farm ChristopherElev. 1555 Location SW SW SW330 Ft. From S Line SW330 Ft. From W Line Quarter

1st. Report

Completion DEC 16 1953Remarks WildcatLohman & Johnson - Contr.Spudding Date 11-29-53Drlg. Data D & A TD 44658" @ 254 Br. lime 3246 Lans. 3256Miss. 4016 DST 4018-25 open 45 min.gas in 30 min. Rec. 45' wtr. cut mud1075# Simp. 4428 TD 4465D & A