


Stanton

KANSAS

SECTION 36 TOWNSHIP 28 RANGE 40W

WELL NO. #2 Heitzman

COMPANY Pan American Petr. Corp.

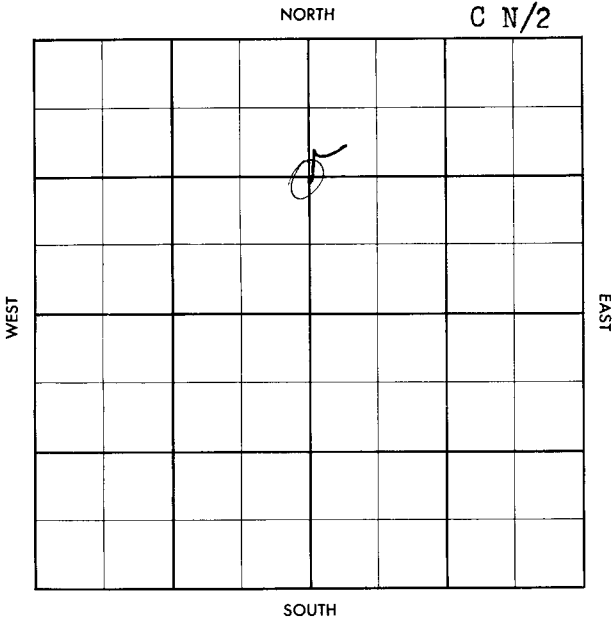

County Stanton Elev. 3243 RB
 Sec. 36 Twp. 28 Rge. 40W
 Company Pan American Pet. Corp.
 Farm Name Heitzman No. 2

TOPS	DEPTH	LOG	DATUM	Loc. in Sec.
Anh.				50' E of
Tr.				C N/2
Do.				
Bl.				
L.				
K.C.				Geol.
B.K.C.				Conte
Ce.				Noble Drlg.
C.				
M.				Pool
M.				Hugoton
K.				
Ms.				
Me.				
V.				
S.				
S.				
A.				
R.				
Pe.				
G.				
Ed.				

FIRST REPORT
 FEB 20 '57

Date Comm.

W O C R

34

3240 DF

County Stanton Elev. 3243 RB
 Sec. 36 Twp. 28 Rge. 40W
 Company Pan American Pet. Corp.
 Farm Name Heitzman No. 2

TOPS	DEPTH	LOG	DATUM	Loc. in Sec.
Anh.				50' E of
Tp.				C N/2
H. <u>14617-1471</u>		<u>227</u>		
Tr. <u>227</u>		<u>227</u>		
Dg. <u>227</u>		<u>227</u>		
BL.				
L.				
K.C.				Geol.
B.K.C.				Contr.
Ce.				Noble Drlg.
C.				
M.				Pool
M.				Hugoton
K.				
Mz.				
Ma.				
V.				
S.				
S.				
A.				
R.				
Pe.				
G.				
TD.	<u>2425</u>			

APR 17 '57

COMPLETE

Date Comm.

W O C R

SPD 2-27-57

P. 18 6P. 120' 5' 20 2+3 100

120' 2+20 2+20 2+20 2+20

P. 237P-20' F. 12 13X10 500

1.38 M.F. + 1.1 F. 4P. 10

2350 120 2350 30 1.2 2341-70

9a 750 M.F. 50 F. 12 13X10 500

9a 2.147 M.F. 60 + 120 Gwph 9a.

2.83 M.F. 60 + 10 Gwph Killed well

CO 2398 ga 2.49 MCFG + 10 Gwph
Blowing to dry. 51

20" ~~of~~ Flow ga 5.165
MCFG thru T69.