

Well History

KINGMAN CO. 7/11/71 A 11/12/71

1250' FSL X 2591' FEL Section 11-28S-39W

Panama Council Grove Field

Stanley County, Kansas

T.D. 2805'

'B.D. 2801'

levation 3148' KB

ompletion Date

asing History

8-5/8" 23# CSA 688' w/ 400 SX CIRC
5 1/2" 14# CSA 2805' w/ 510 SX (CIRC)

logs Available: Acoustic Celerity, Temp. Survey,

Present Producing Interval: Council Grove 2582-2783'

ormation Tops: Chose 2269'

Council Grove 2558'

ompletion Record: Subject well Spudded and drilled to total

depth of 2805' w/no special surveys, Set CSg, Log, Perf.

282-86, 2628-55, 2674-78, 2698-2700, 2716-18, 2730-28 X 276 1/2 83' 1/2 CSg

~~72 HR BHP 15000 # SN~~, SWB CSg DRY, Acc x 2500 51 150% x 126 FWS 51 1/2


AVG TP 550 #, AIR 100 BPM, SWB CSg Rec. 65 BLW 2 HRS, Well Kicked 329

2.3 MFCAD X 28-70 HR SI FWS 72 HR BHP, SURF FWS 329 #, FRAC X 25,000


sol. WTR X 25000 # SN, AVG TP 800 #, AIR 80 BPM, RAN Temp Survey, All zones Fracked

except 2nd zone, KICK 24' 711 #, Clean out from 2767-2801' 20 FWS X 11,000

sol. WTR X 100 # SN, AVG TP 1477 # AIR 169.5 BPM, Co From SAND, Well Kicked
FF, RAN 10, Flow to Clean W.

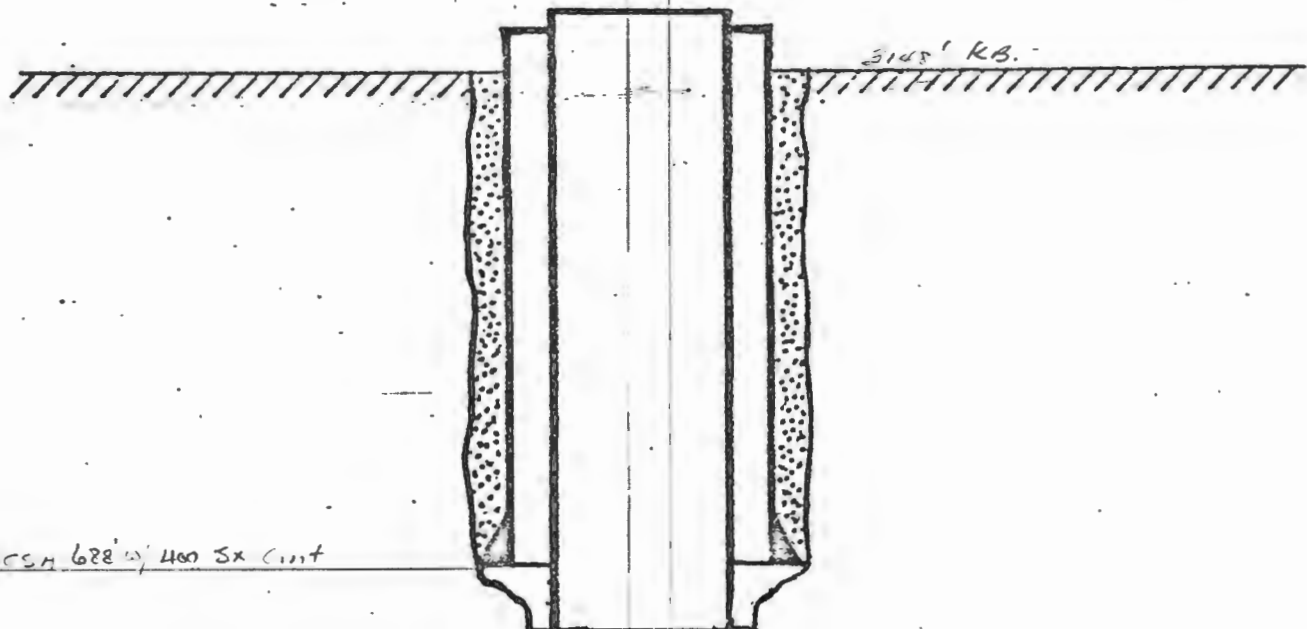

8 5/8" 23 HCSA 628' w/ 400 SX Cmt

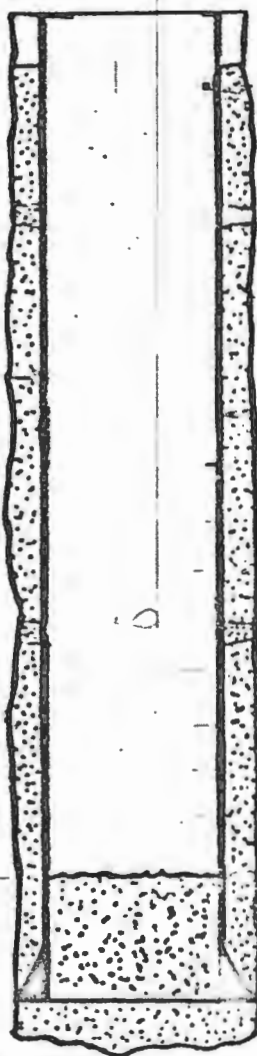

2628-55' w/ 2 JSPF

2628-55' w/ 2 JSPF

2674-18' w/ 2 JSPF





5 7/8" 23 HCSA 628' w/ 400 SX Cmt

FD 2801'

5 1/2" 14 HCSA 2805' L, 510 SX Cmt C

TD 2815'

AMOCO PRODUCTION COMPANY

SCALE:

DATE:

DRG.

NO.