


Kingman KANSAS

Section 4 Township 28 Range 5W
Well No. 1 Ramsdale
Company Trans-Era Petr.

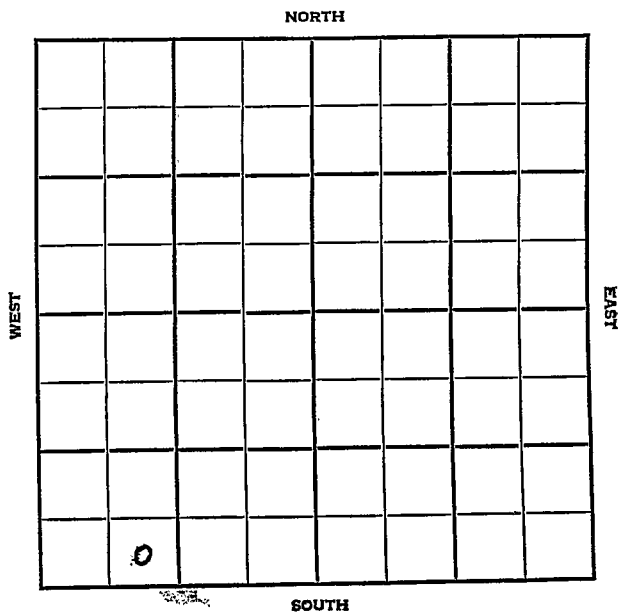

Kingman KANSAS

SEC.	TWP.	R.
4	28	5W

WELL NO.

1 Ramsdale

FARM

COMPANY

Trans-Era Petr.

CONTRACTOR

Co. Tools


Lansdowne Pool

Ft. from N. Line

330 Ft. from S. Line

Ft. from E. Line

990 Ft. from W. Line

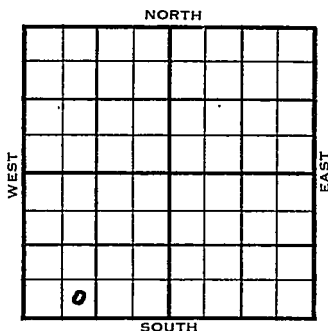

SE SW SW

Magnolia Farmout

1954

ELEVATION

1425'

REPORT

8/25

Spud 8-14-54

8" @ 165'

Heeb 2670', Br. Lime 2954', KC 2976'

Drlg. 3378'

9/1

Spud 8-14-54 - D&A

TD 3827'

8" @ 165'

Heeb 2670', Br. Lime 2954', KC 2976',

Miss 3780', Miss dol 3820'


TD 3827'

DST 3816-27, opn 1 hr., rec. 100' mud,
1350#

D&A

ABANDONED.

County Kingman State Kansas
 Sec. 4 (Blk.) 28 (Sur.) 5W Map No.
 Operator Trans-Era Pet.
 Well No. 1 Farm Ramsdale
 Elev. _____ Location SE SW SW

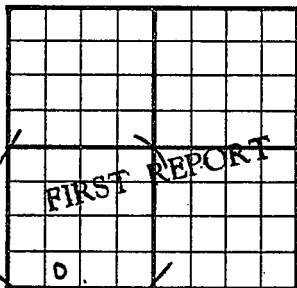

330 Ft. From S Line SW
990 Ft. From W Line Quarter

1st. Report AUG 25 1954

Completion _____

Remarks Magnolia farmout
Co. tools

Spudding Date 8-14-54

Drlg. Data _____


Lansdowne Pool

8" @ .165 Heeb. 2670 Br. line 2954

KC 2976 drlg. 3378

F BEN GILSTRAP

County Kingman State Kansas
 Sec. 4 (Blk.) 28 (Sur.) 5W Map No.
 Operator Trans-Era P_et.
 Well No. 1 Farm Ramsdale
 Elev. 1425 Location SE SW SW

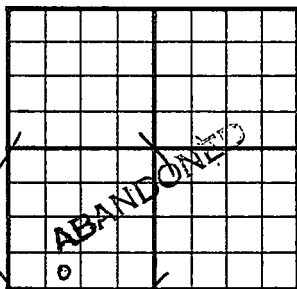

330 Ft. From S Line SW
990 Ft. From W Line Quarter

1st. Report

Completion SEP 1 1954

Remarks Lansdowne Pool
Co. tools

Spudding Date 8-14-54

Drilg. Data D & A TD 3827

8" @ 165 Heeb. 2670 Br. lime 2954

KC 2976 Miss. 3780 Miss. dol. 3820

TD 3827 DST 3816-27 open 1 hr. Rec.

100' mud 1350#

D & A

FABEN GILSTRAP